
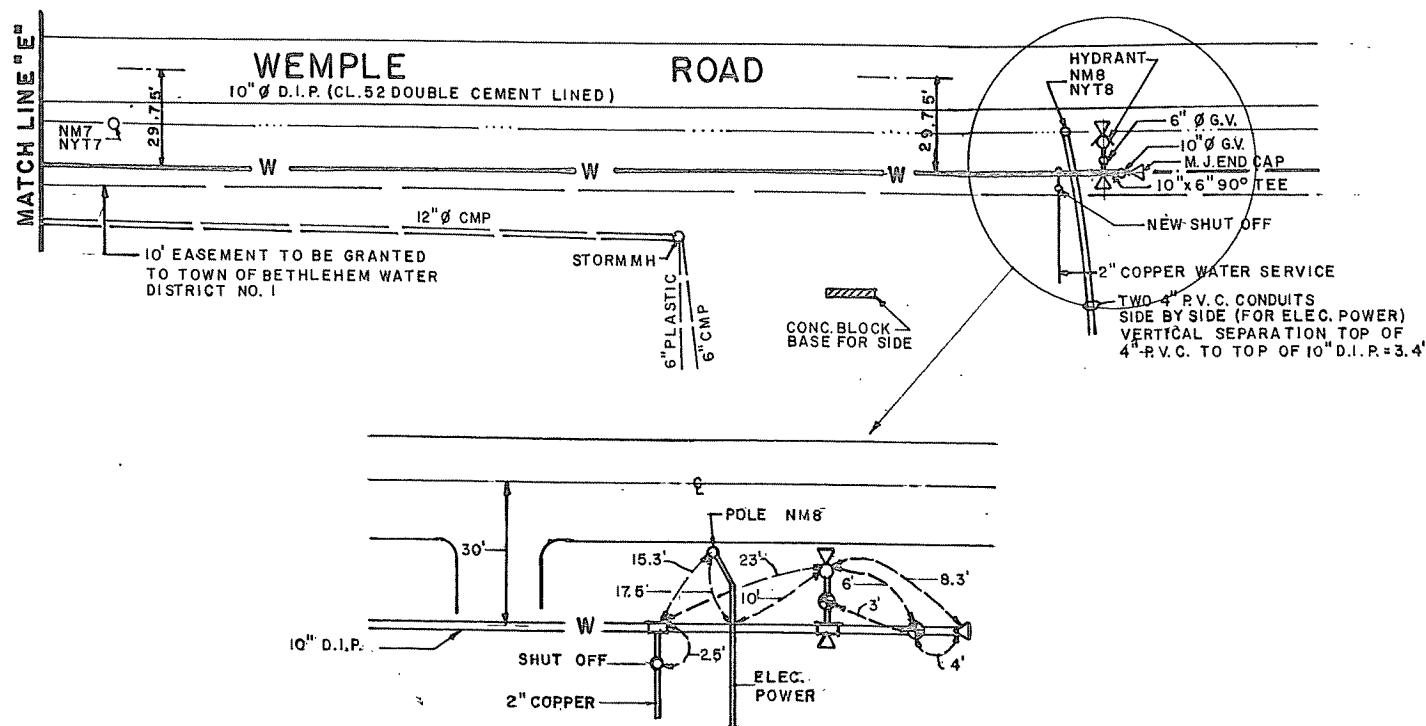


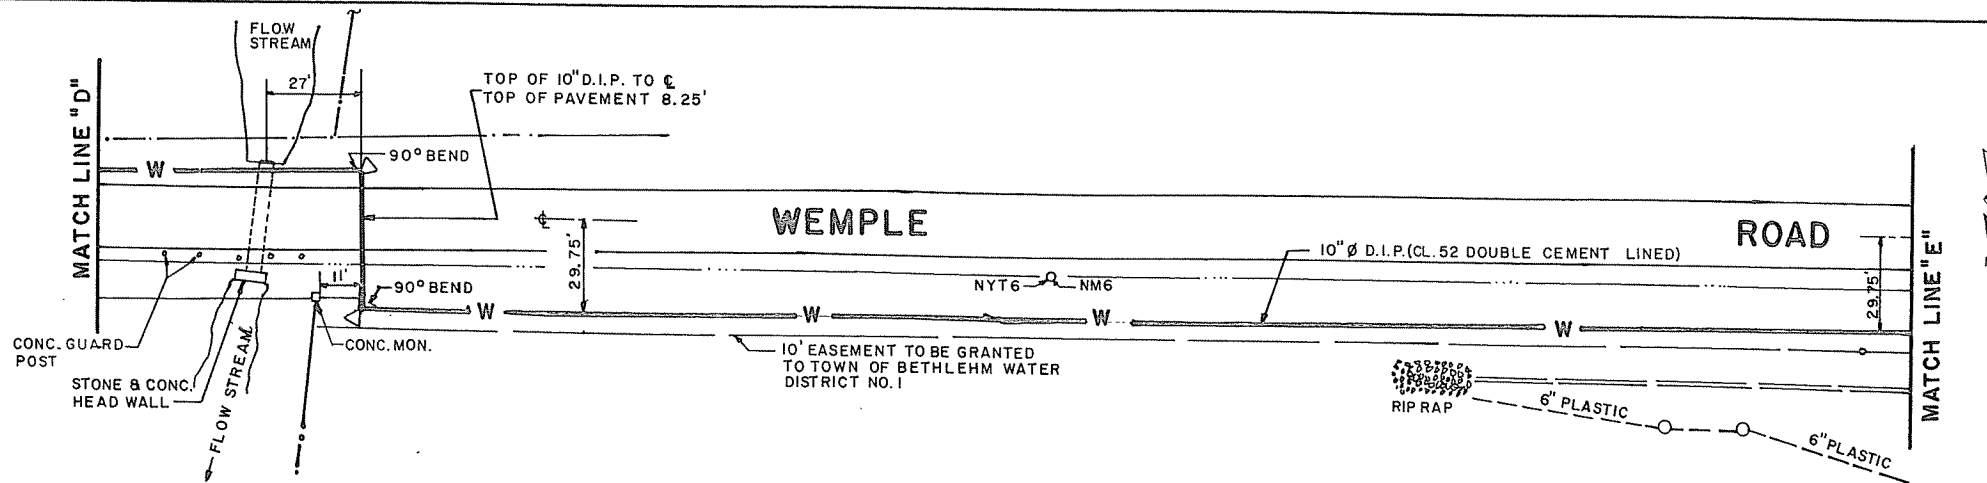

DRAWN BY: MG.
CHECKED BY:

DETAIL
N.T.S.

LOWER WEMPLE RD.
WATER EXTENSION

APRIL 20, 1990
SCALE: 1" = 40'

RECORD
DRAWING