

LYONS AVENUE

WATER DISTRICT NO.1  
TOWN OF BETHLEHEM


RECORD OF INSTALLATION

TOWN OF BETHLEHEM ENGINEERING

DEPARTMENT

SCALE 1"=50' DECEMBER, 1981

DWN BY: PDH

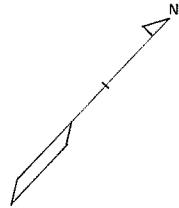

LYONS AVENUE

ROAD

PARTRIDGE

(27)

(15)

(11)

LYONS

AVENUE

(26)

(16)

(12)

(10)

(30)

51'  
55'

