


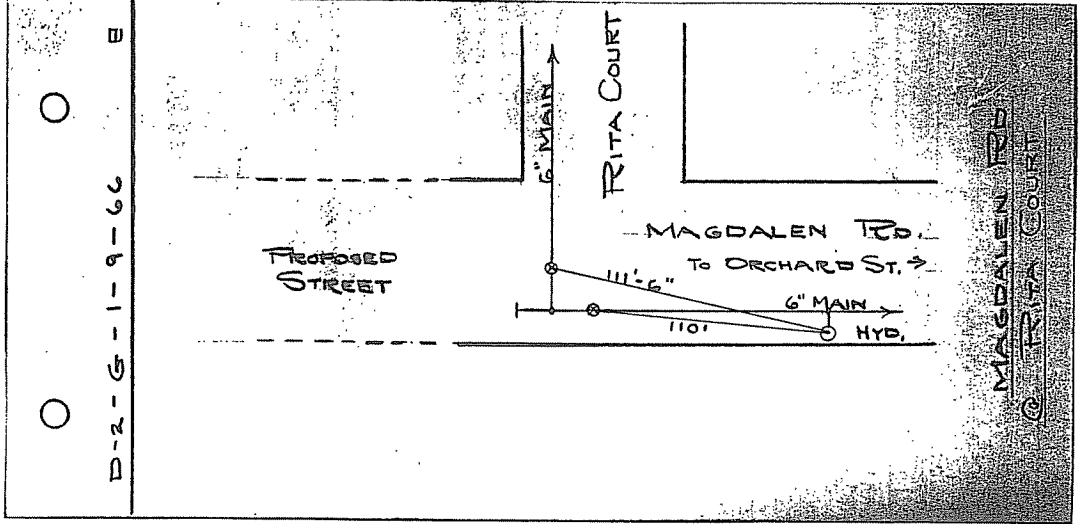

MAGDALEN ROAD
WATER MAIN