


JOLLEY ROAD

8" WAT. MAIN CONNECTION
VALVE TO BE A TAPPING SLEEVE AND
GATE VALVE

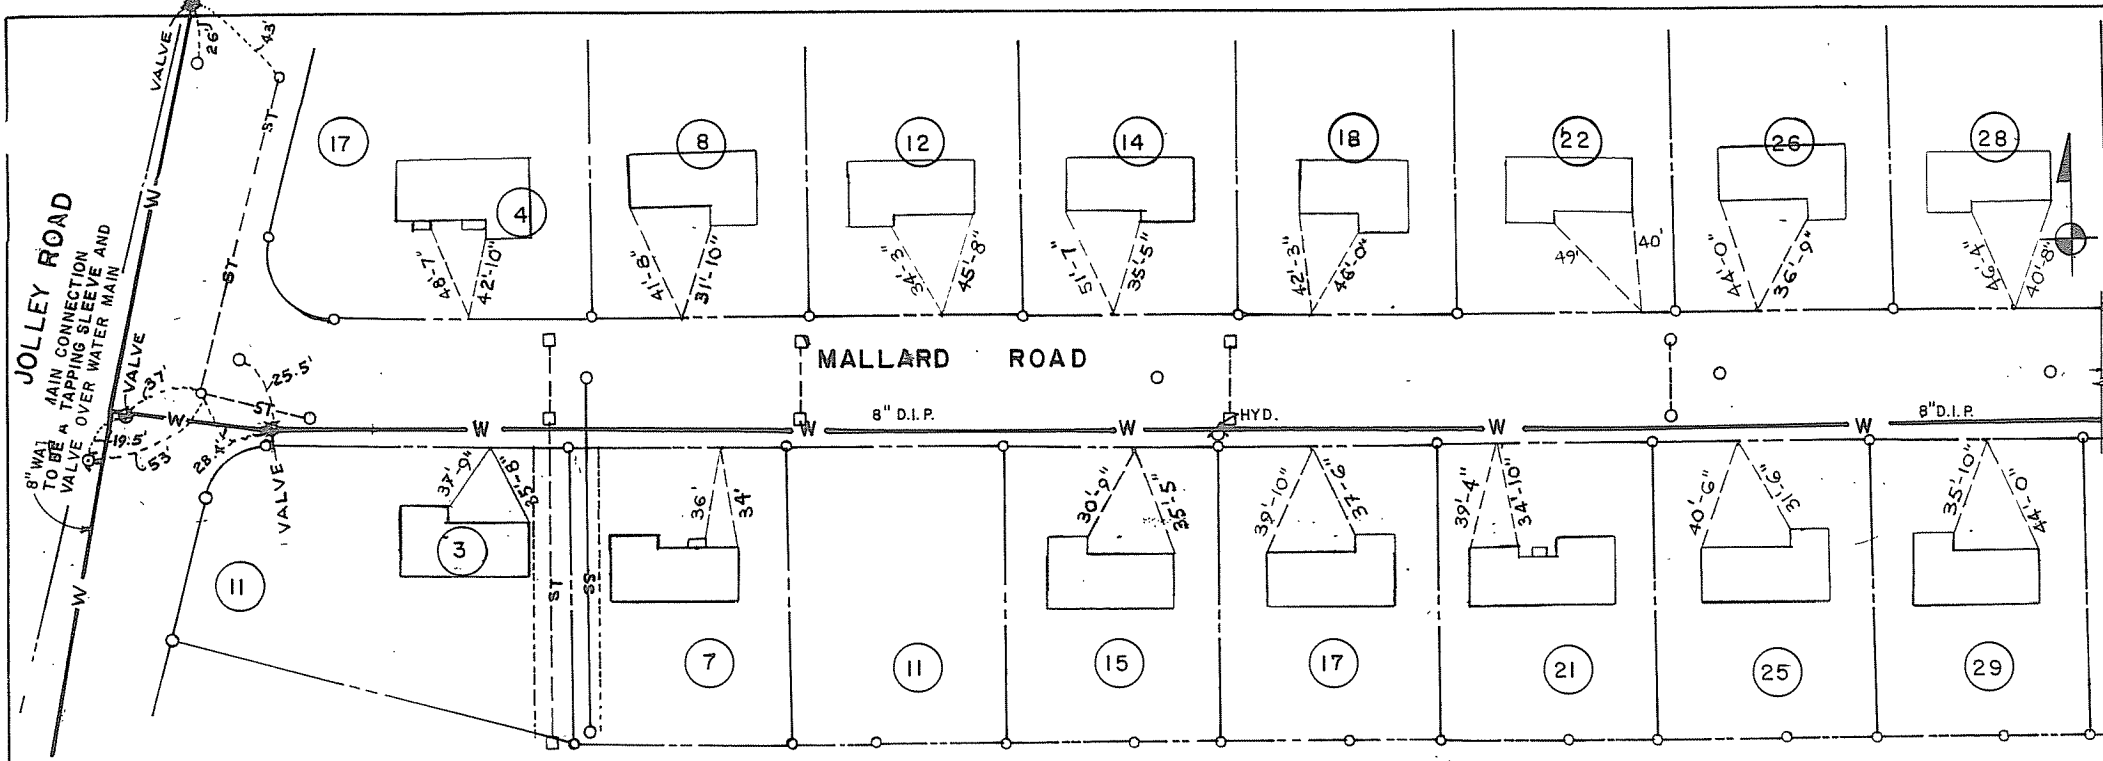

LEGEND

- CATCH BASIN
- MANHOLE
- ⊕ HYDRANT
- ⊕ GATE VALVE
- ⊕ TEE
- ▲ THRUST BLOCK
- W— WATER MAIN

MALLARD ROAD WATER MAIN & CURB BOXES

JULY 1990

1" = 50'

JOHN CROSS EXCAVATING

DRAWN BY: M.G.
CHECKED BY: D.M.S.

0021 451222