


JOLLY ROAD

8" WATER MAIN CONNECTION
TO BE A TAPPING SLEEVE AND
VALVE OVER WATER MAIN

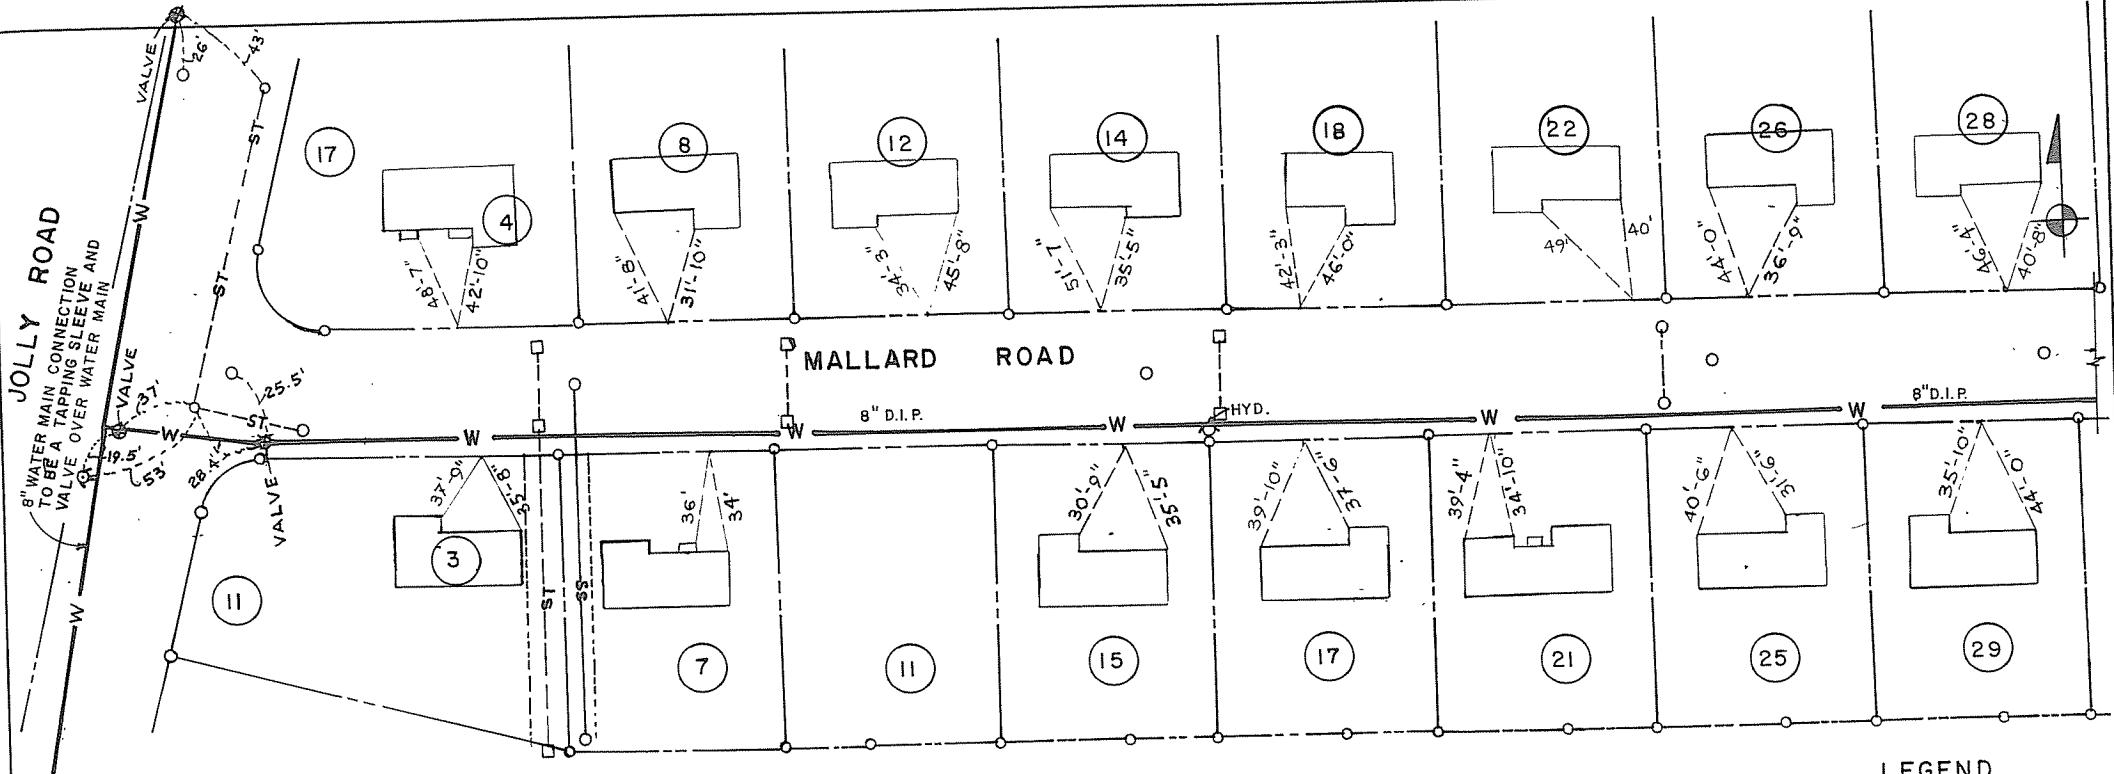

LEGEND

- CATCH BASIN
- MANHOLE
- HYDRANT
- ⊕ GATE VALVE
- └ TEE
- △ THRUST BLOCK
- W WATER MAIN

MALLARD ROAD
WATER MAIN & CURE BOXES
JULY 1990
1" = 50'
JOHN CROSS EXCAVATING