


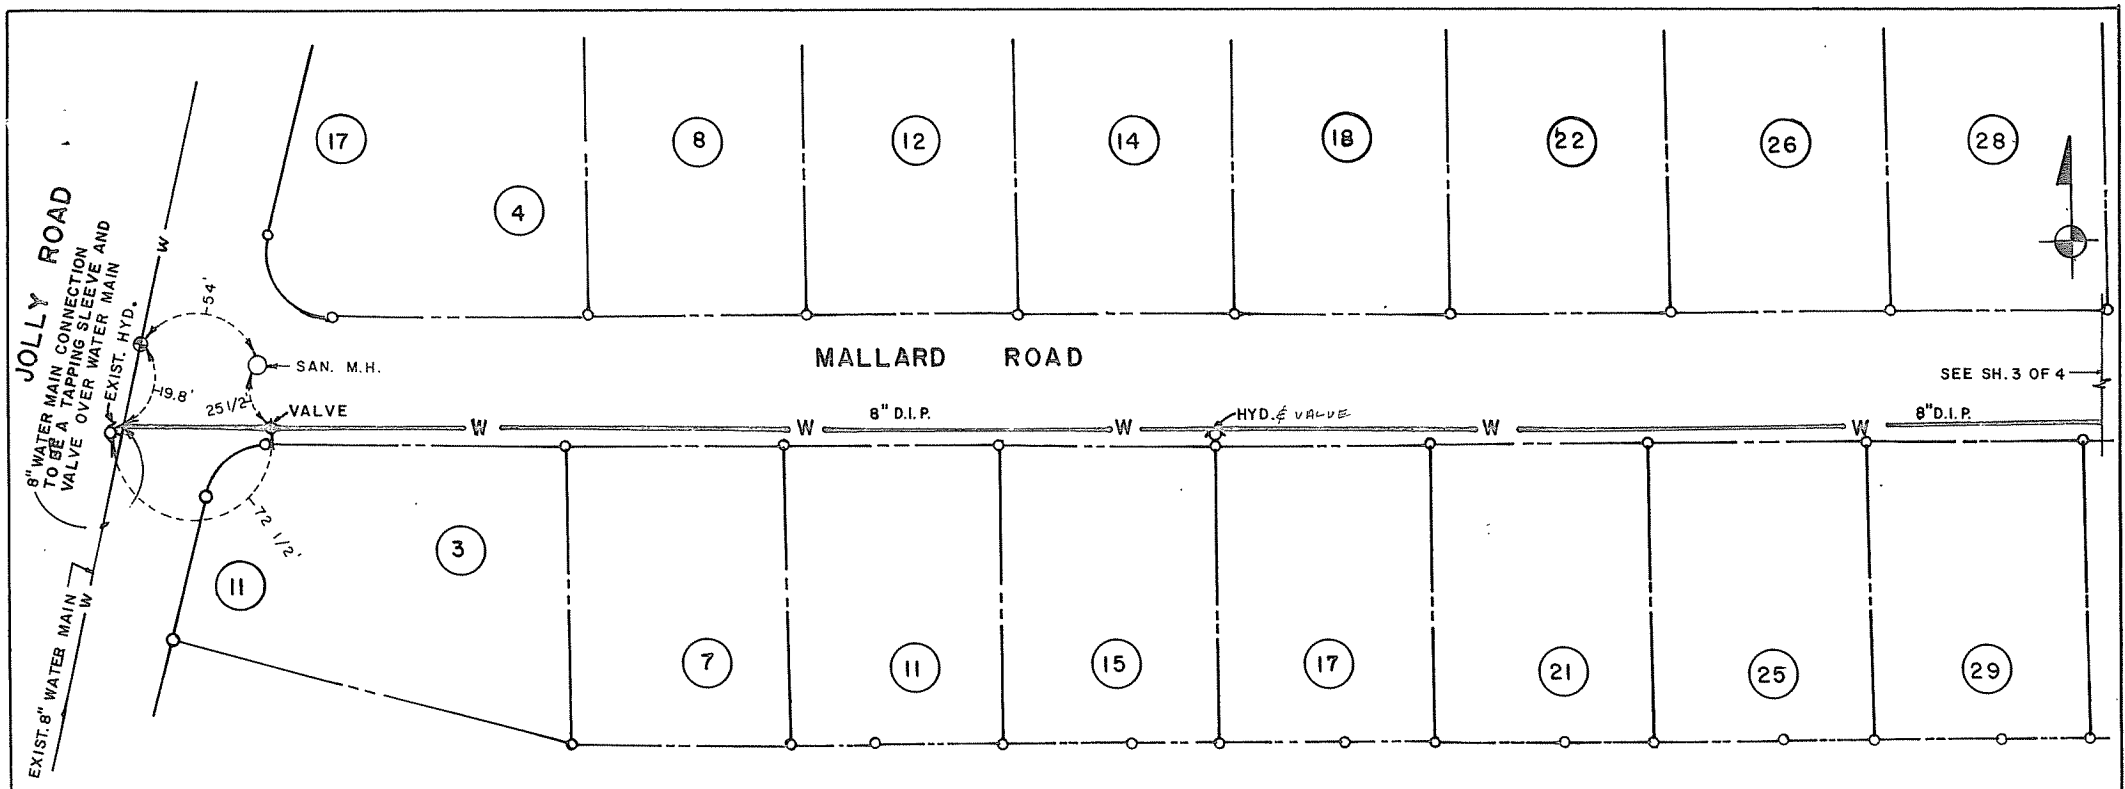

MALLARD ROAD
WATER MAIN
JULY 1990
1" = 50'
JOHN CROSS EXCAVATING

DRAWN BY: M.G.
CHECKED BY: D.M.S.