


JOLLY ROAD

8" WATER MAIN CONNECTION  
TO BE A TAPPING SLEEVE AND  
VALVE OVER WATER MAIN  
EXIST. 8" WATER MAIN

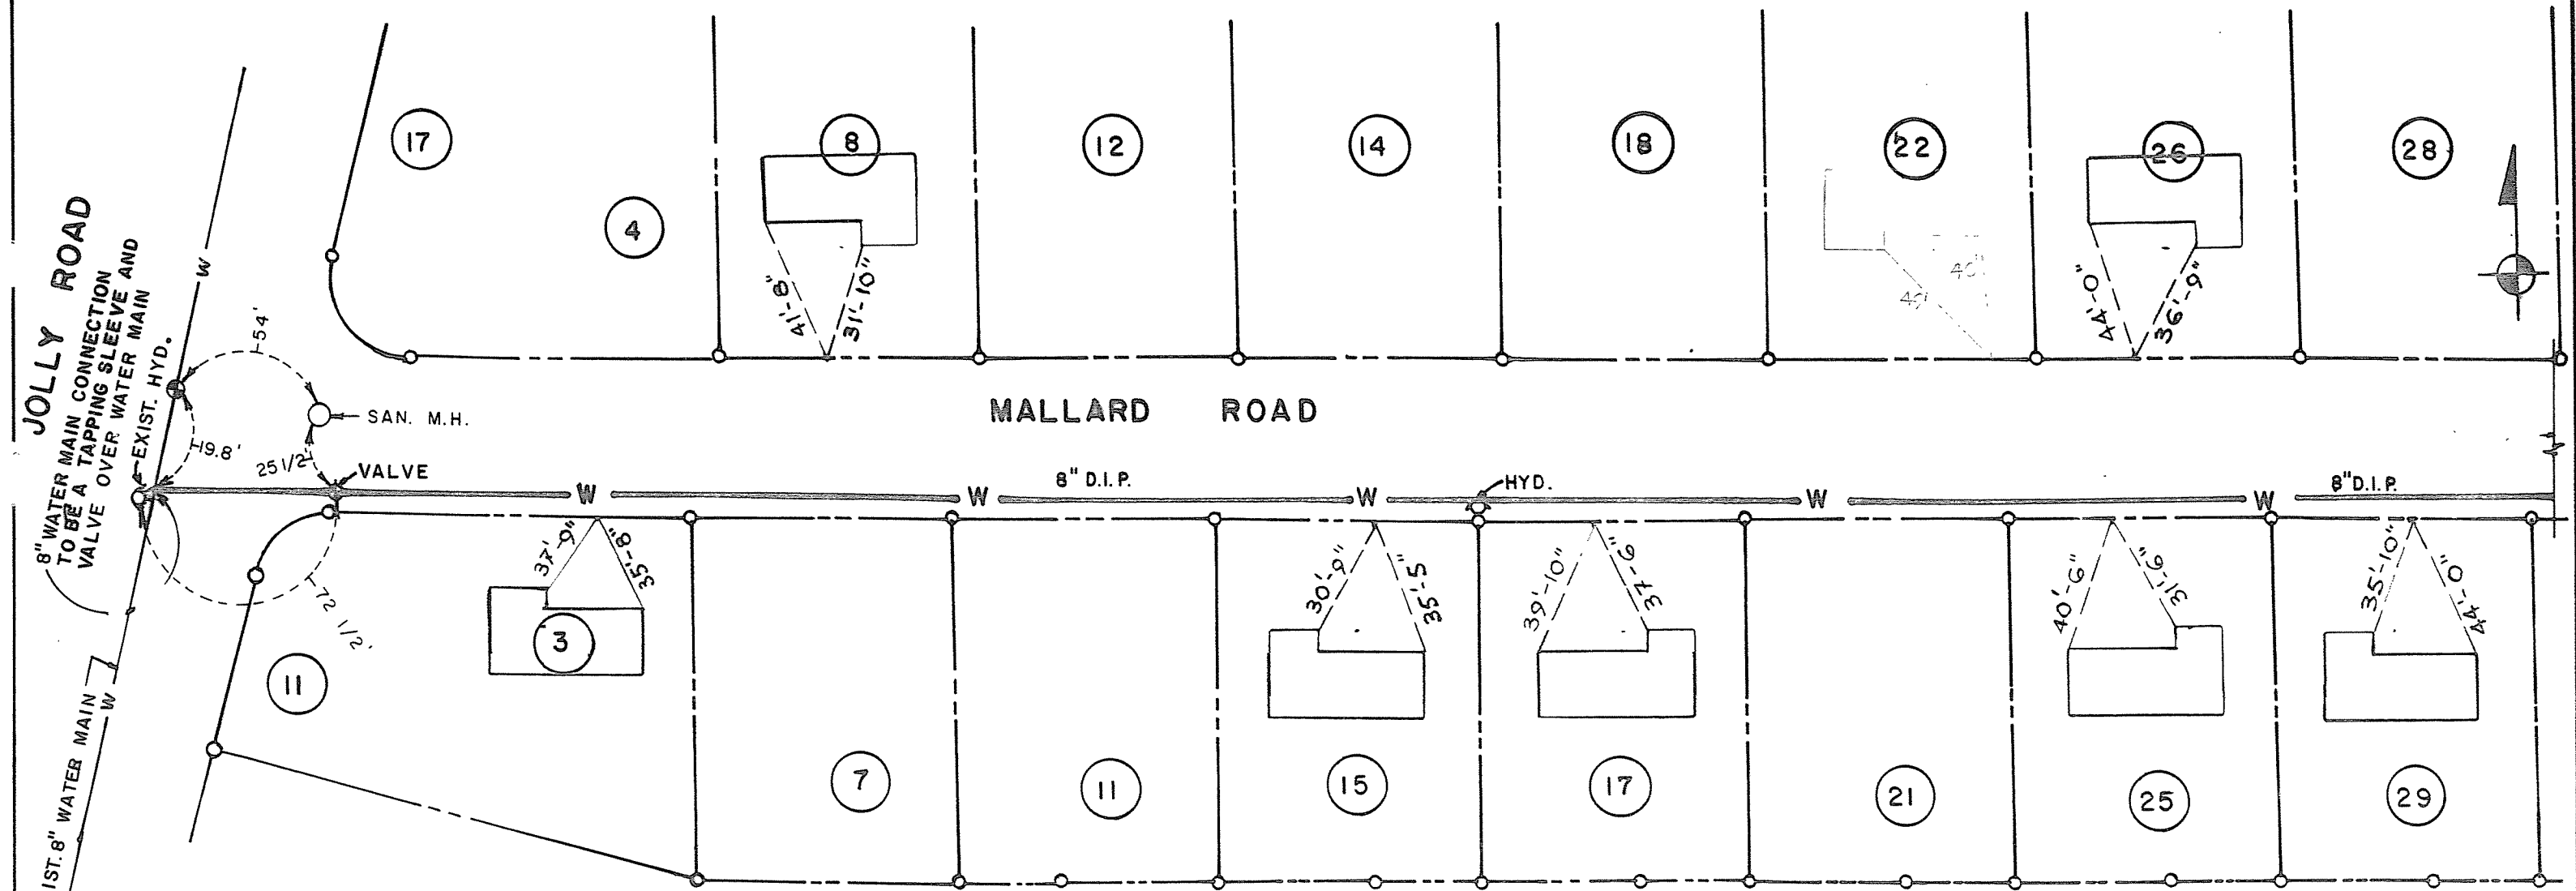

**MALLARD ROAD**  
**WATER MAIN & CURB BOXES**  
 JULY 1990  
 1" = 50'  
 JOHN CROSS EXCAVATING

DRAWN BY: M.G.  
 CHECKED BY: D.M.S.