



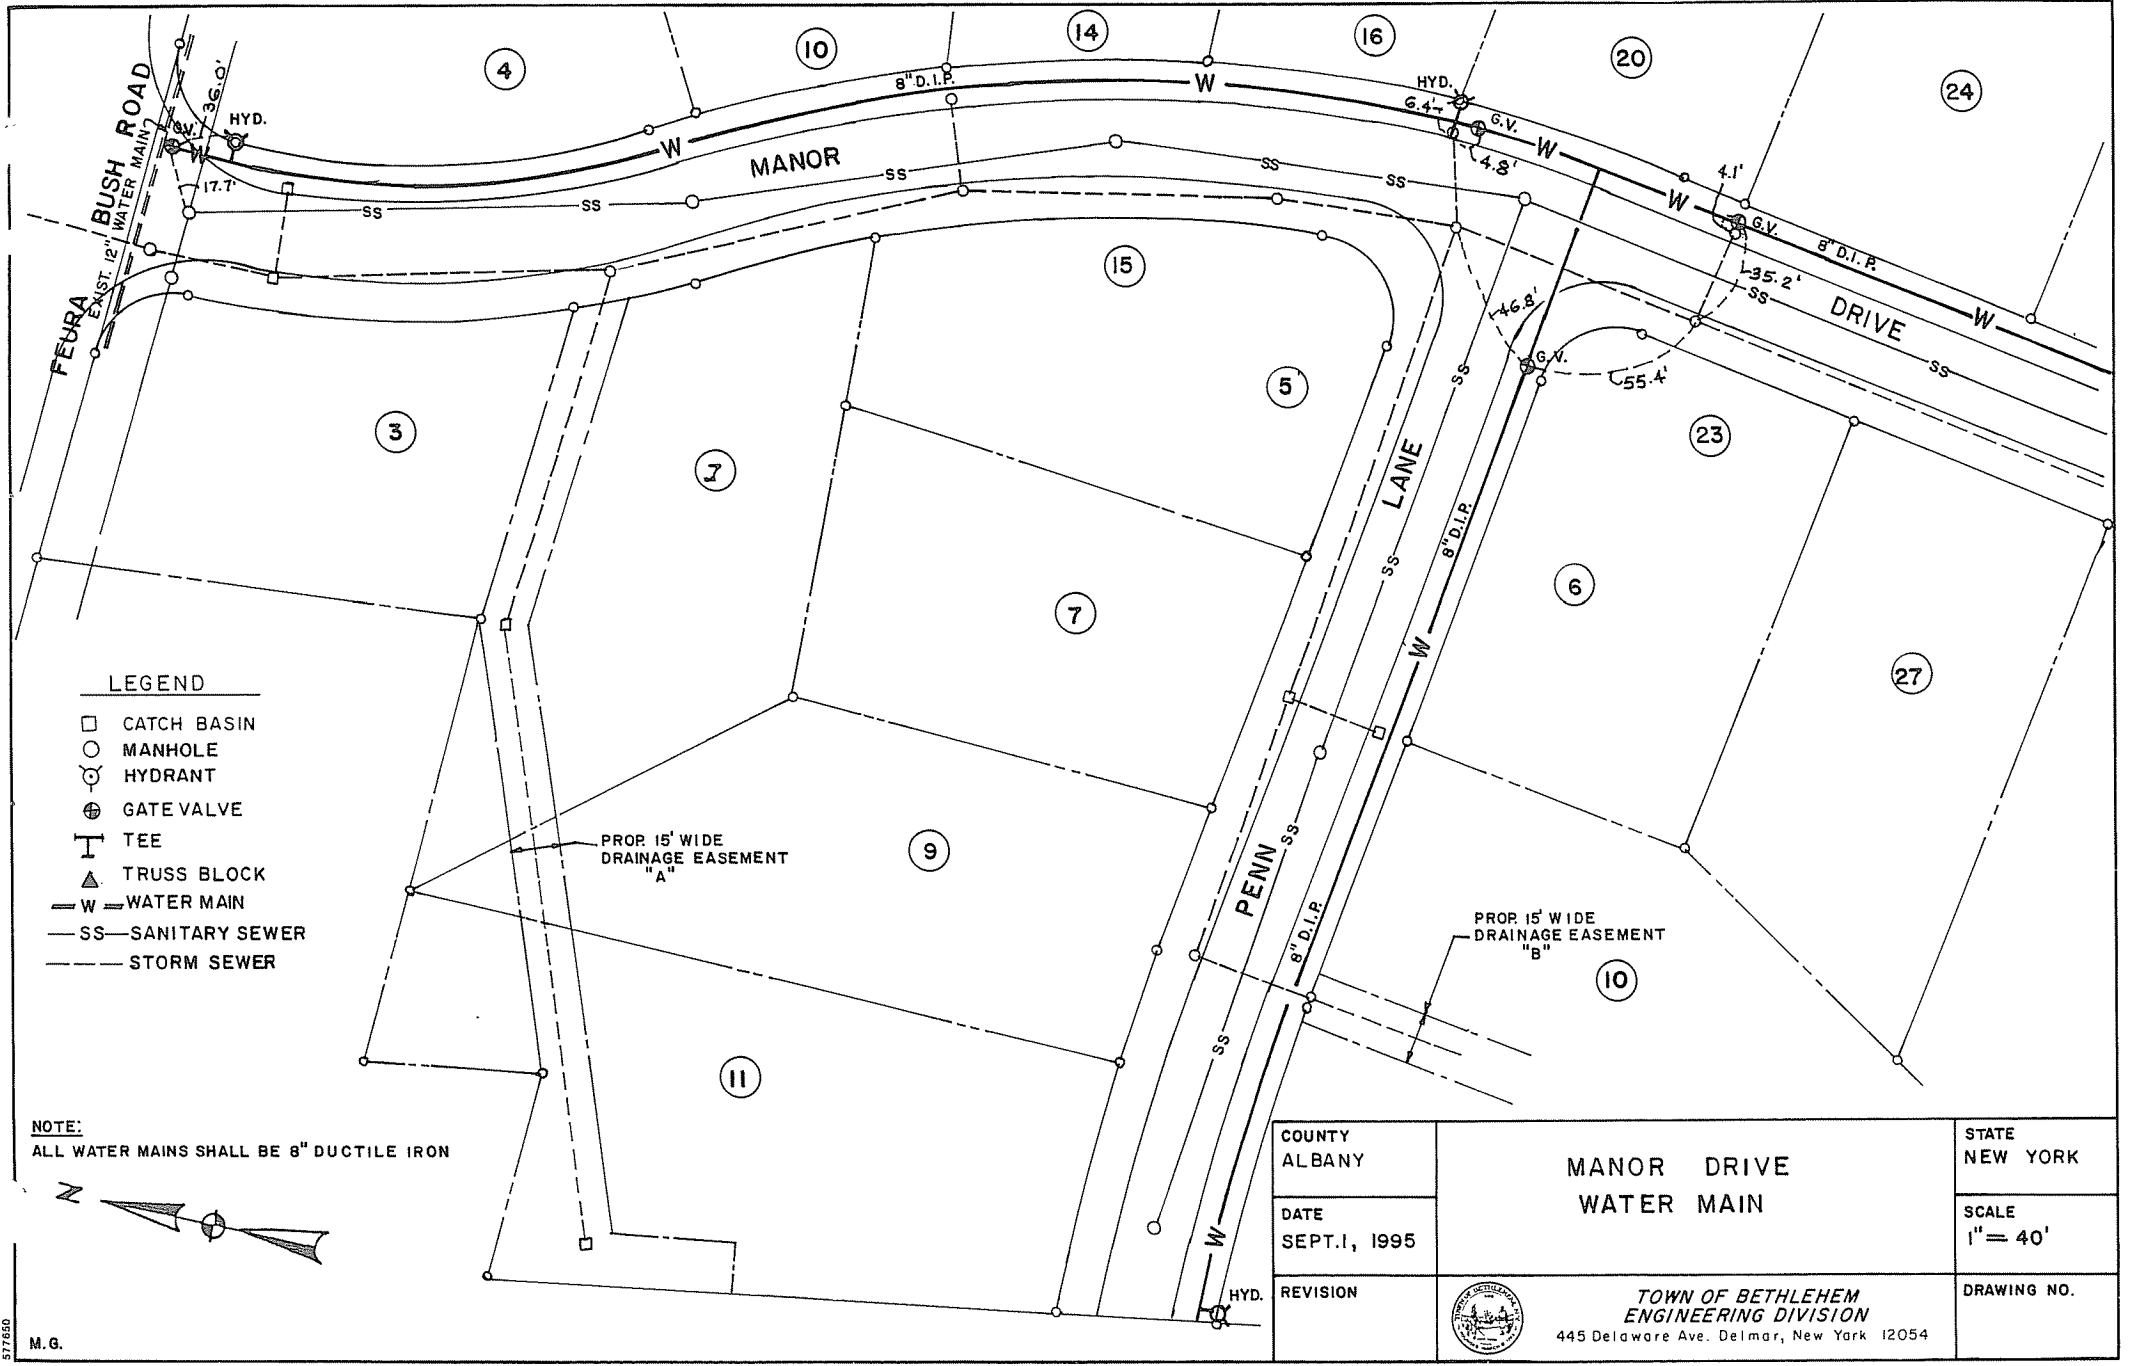

NOTE:
ALL WATER MAINS SHALL BE 8" DUCTILE IRON

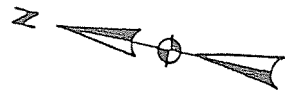

COUNTY ALBANY	MANOR DRIVE WATER MAIN	STATE NEW YORK
DATE SEPT.1, 1995		SCALE 1"= 40'
REVISION	 TOWN OF BETHLEHEM ENGINEERING DIVISION 445 Delaware Ave. Delmar, New York 12054	DRAWING NO.

GLEN MAMOK