




LEGEND

- CATCH BASIN
- MANHOLE
- HYDRANT
- GATE VALVE
- TEE
- TRUSS BLOCK
- W= WATER MAIN
- SS= SANITARY SEWER
- STORM SEWER

NOTE:
ALL WATER MAINS SHALL
BE 8" DUCTILE IRON.

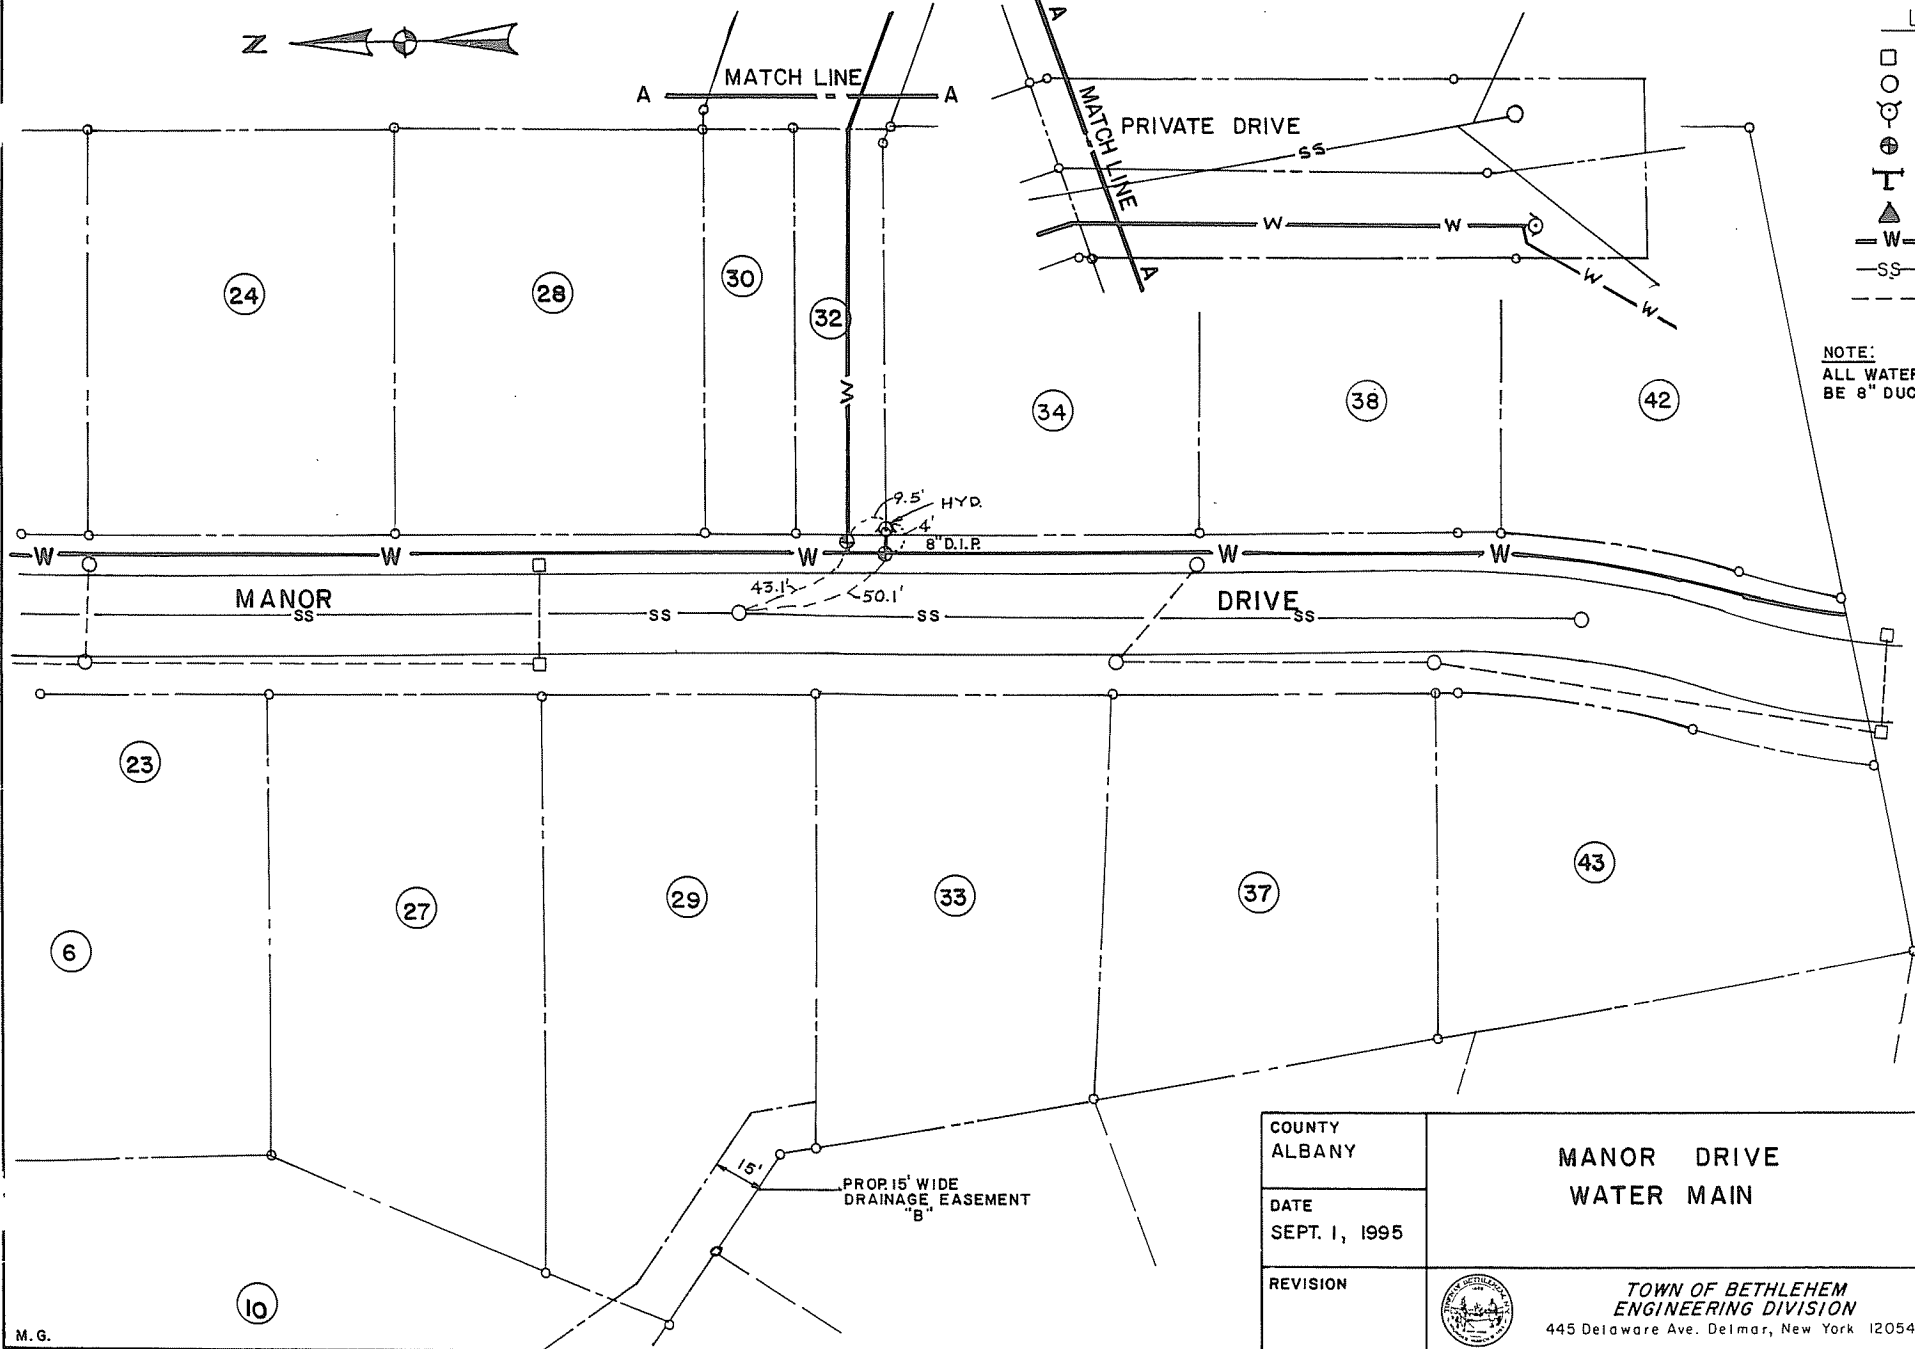

COUNTY ALBANY	MANOR DRIVE WATER MAIN	STATE NEW YORK
DATE SEPT. 1, 1995		SCALE 1" = 40'
REVISION	 TOWN OF BETHLEHEM ENGINEERING DIVISION 445 Delaware Ave. Delmar, New York 12054	DRAWING NO.

GLEN MANOR