

MANOR DRIVE

WATER DISTRICT NO.1


TOWN OF BETHLEHEM

RECORD OF INSTALLATION


SCALE: 1" = 50'

JUNE, 1984

DRWN. BY AW

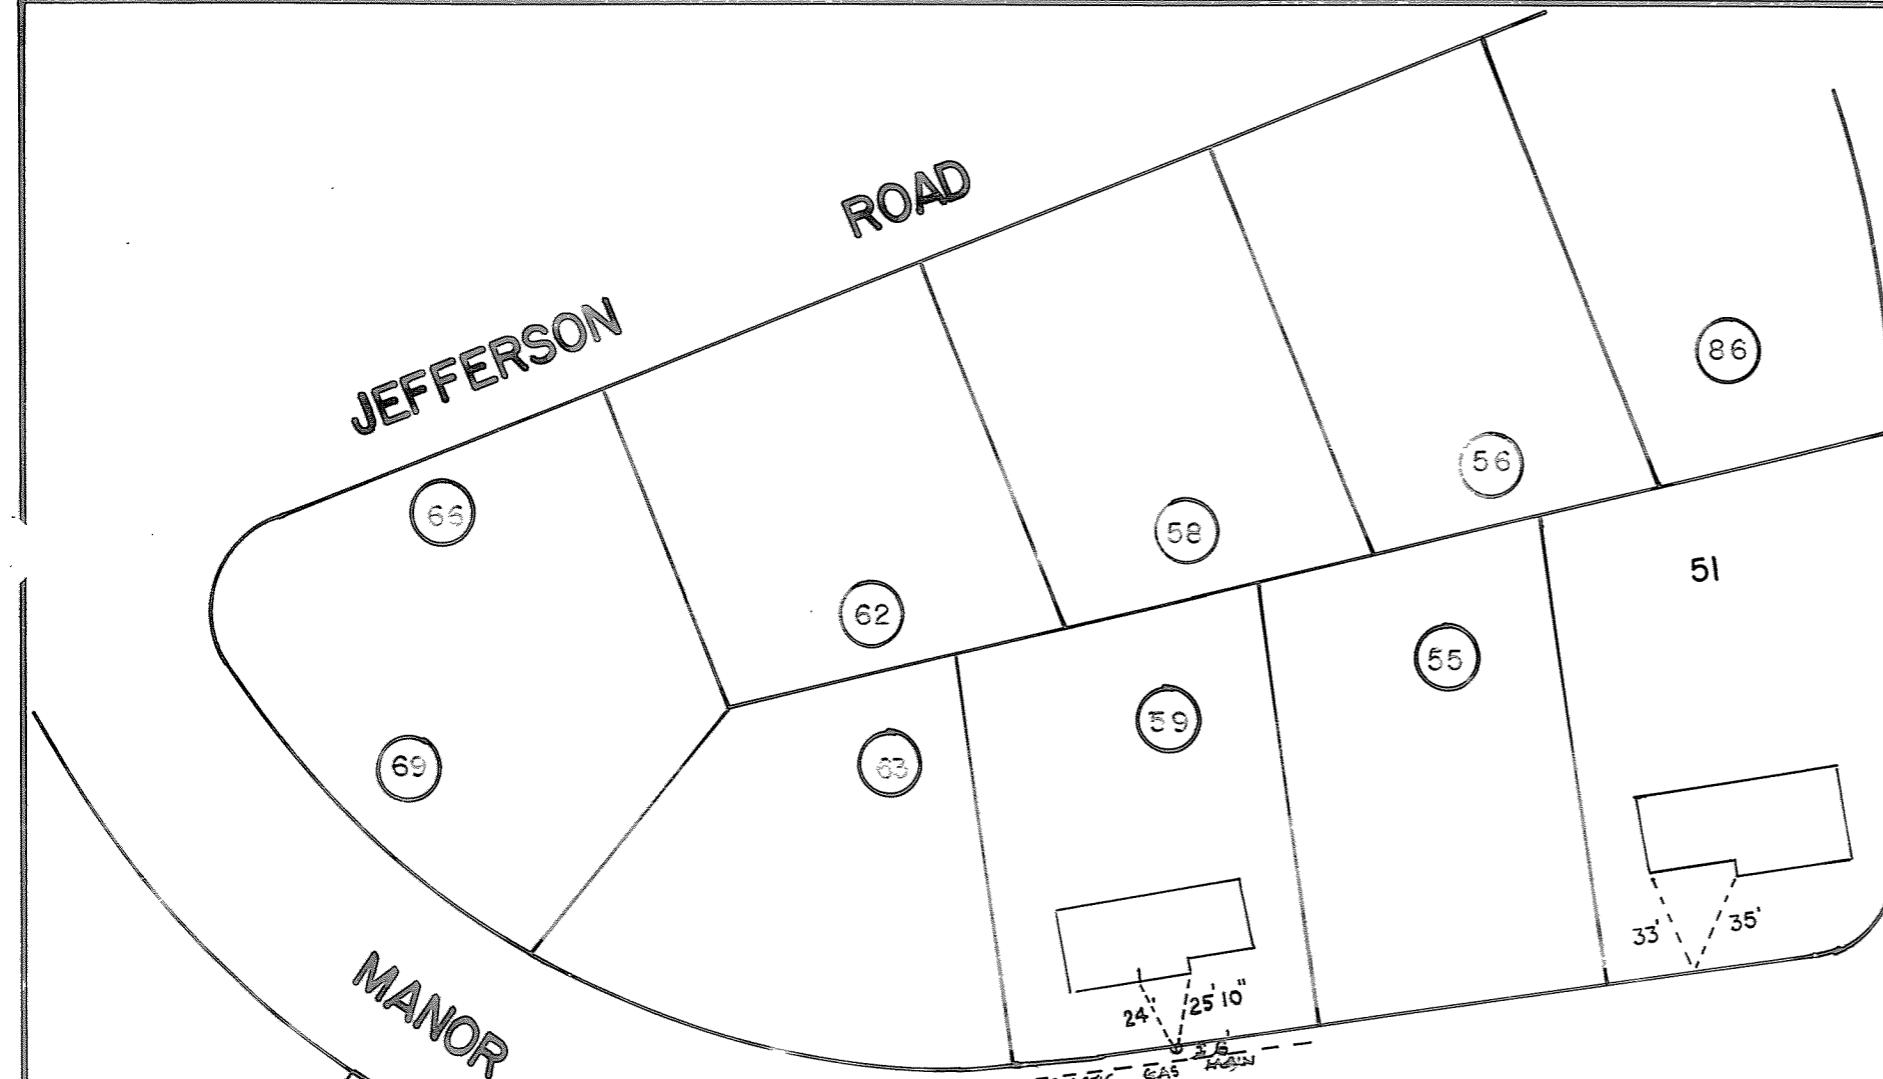

DRIVE

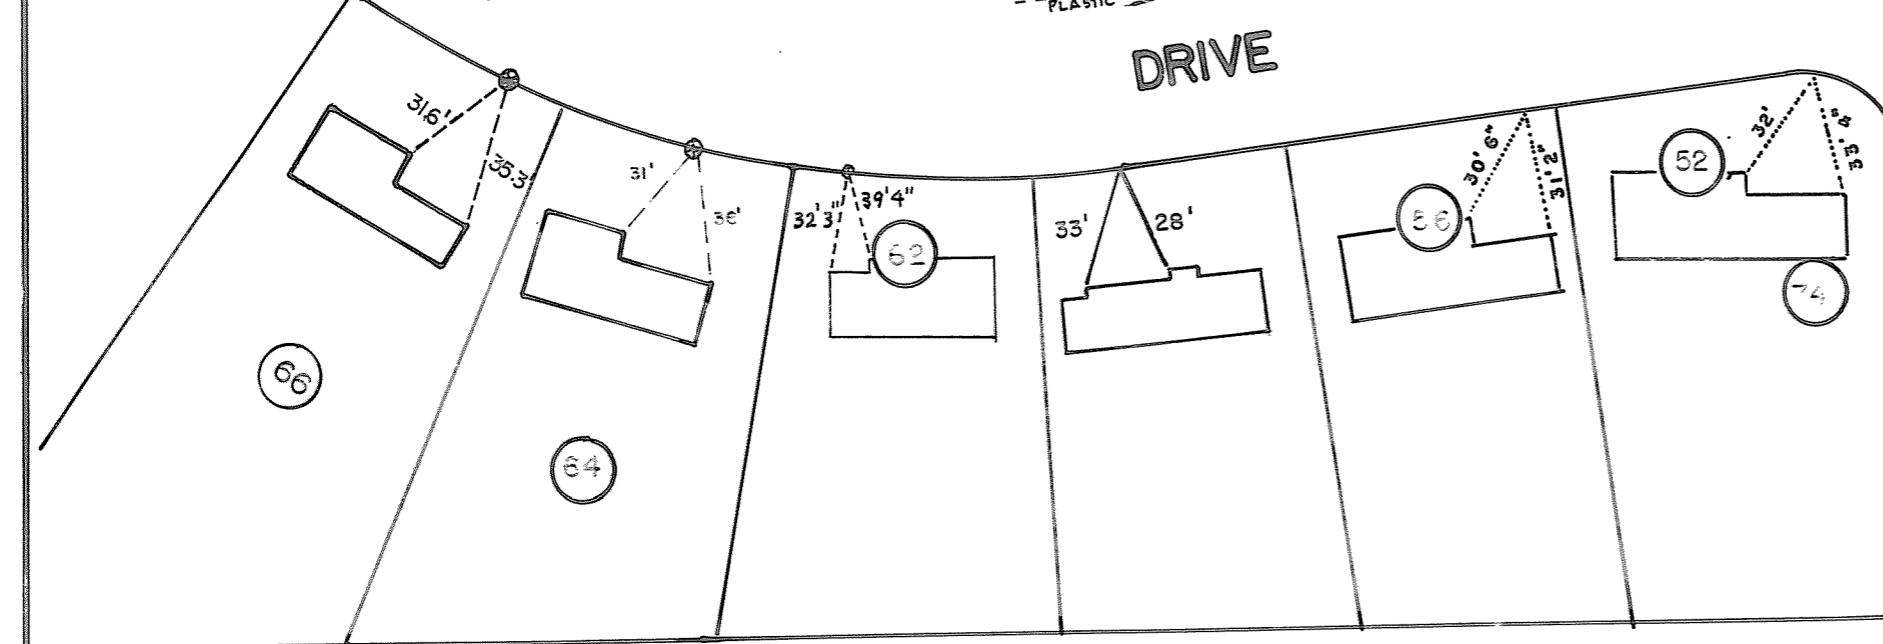

HANCOCK

