

MAPLE AVENUE

(ELSMERE)

WATER DISTRICT NO. 1

TOWN OF BETHLEHEM

RECORD OF INSTALLATION


TOWN OF BETHLEHEM ENGINEERING

DEPARTMENT

SCALE: 1"=50' FEBRUARY, 1982

DWN. BY: PDH


N

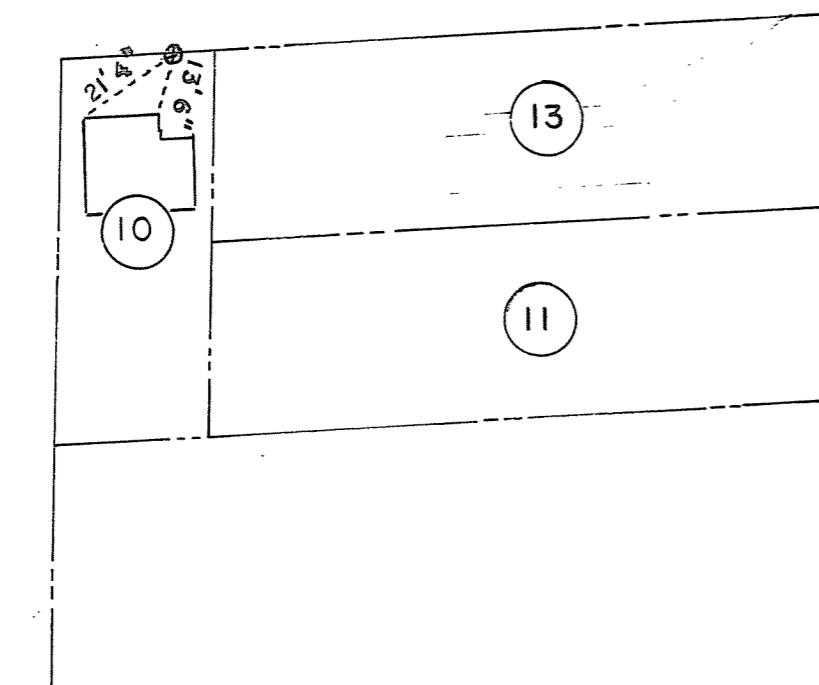

GLENDALE

AVENUE

MAPLE

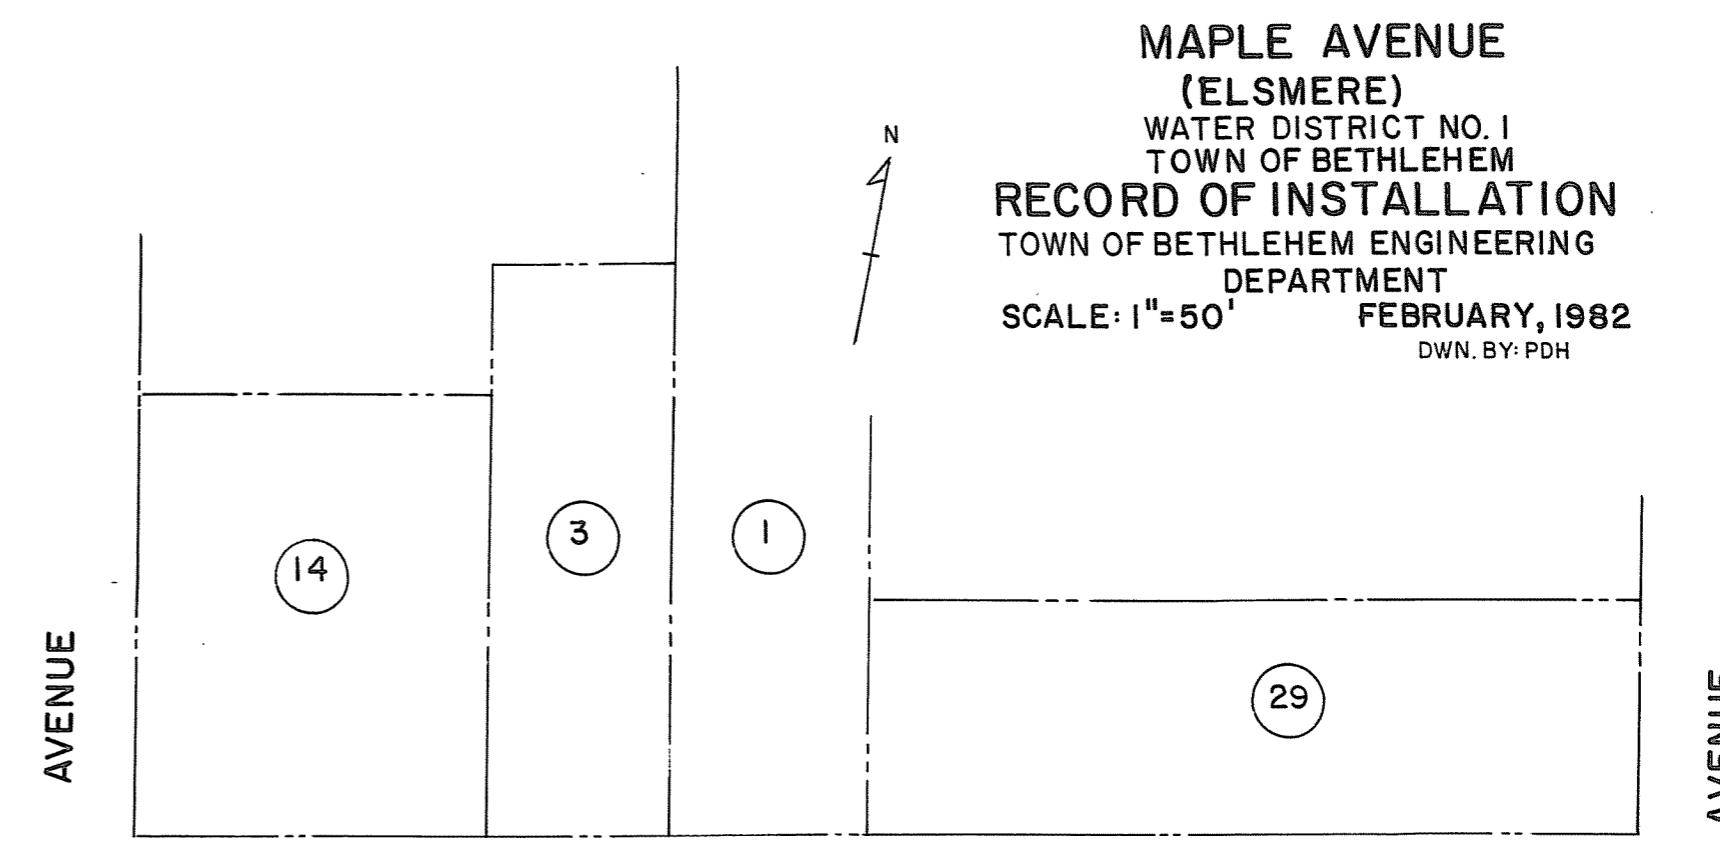

AVENUE

ELSMERE