

MARLBORO ROAD

AND

FOREST ROAD

WATER DISTRICT NO.1

TOWN OF BETHLEHEM


RECORD OF INSTALLATION

TOWN OF BETHLEHEM ENGINEERING

DEPARTMENT

SCALE 1"=100' DECEMBER, 1981


DWN BY: PDH

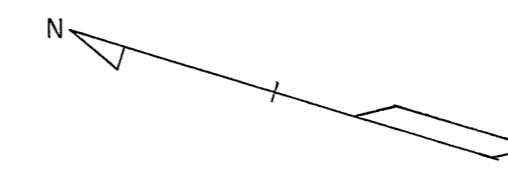

WELLINGTON ROAD

FOREST  
ROAD

ADAMS  
PLACE

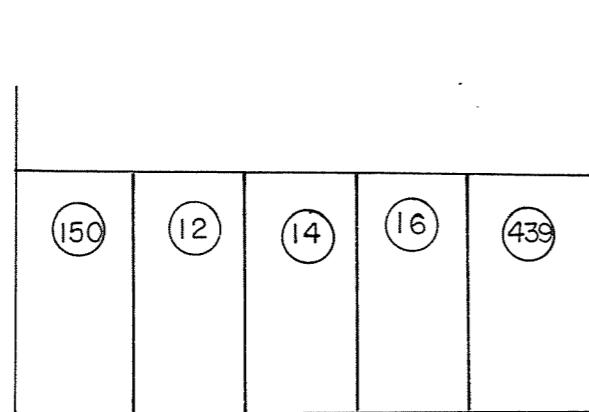

ROAD

OLD  
ROAD

MARLBORO

