


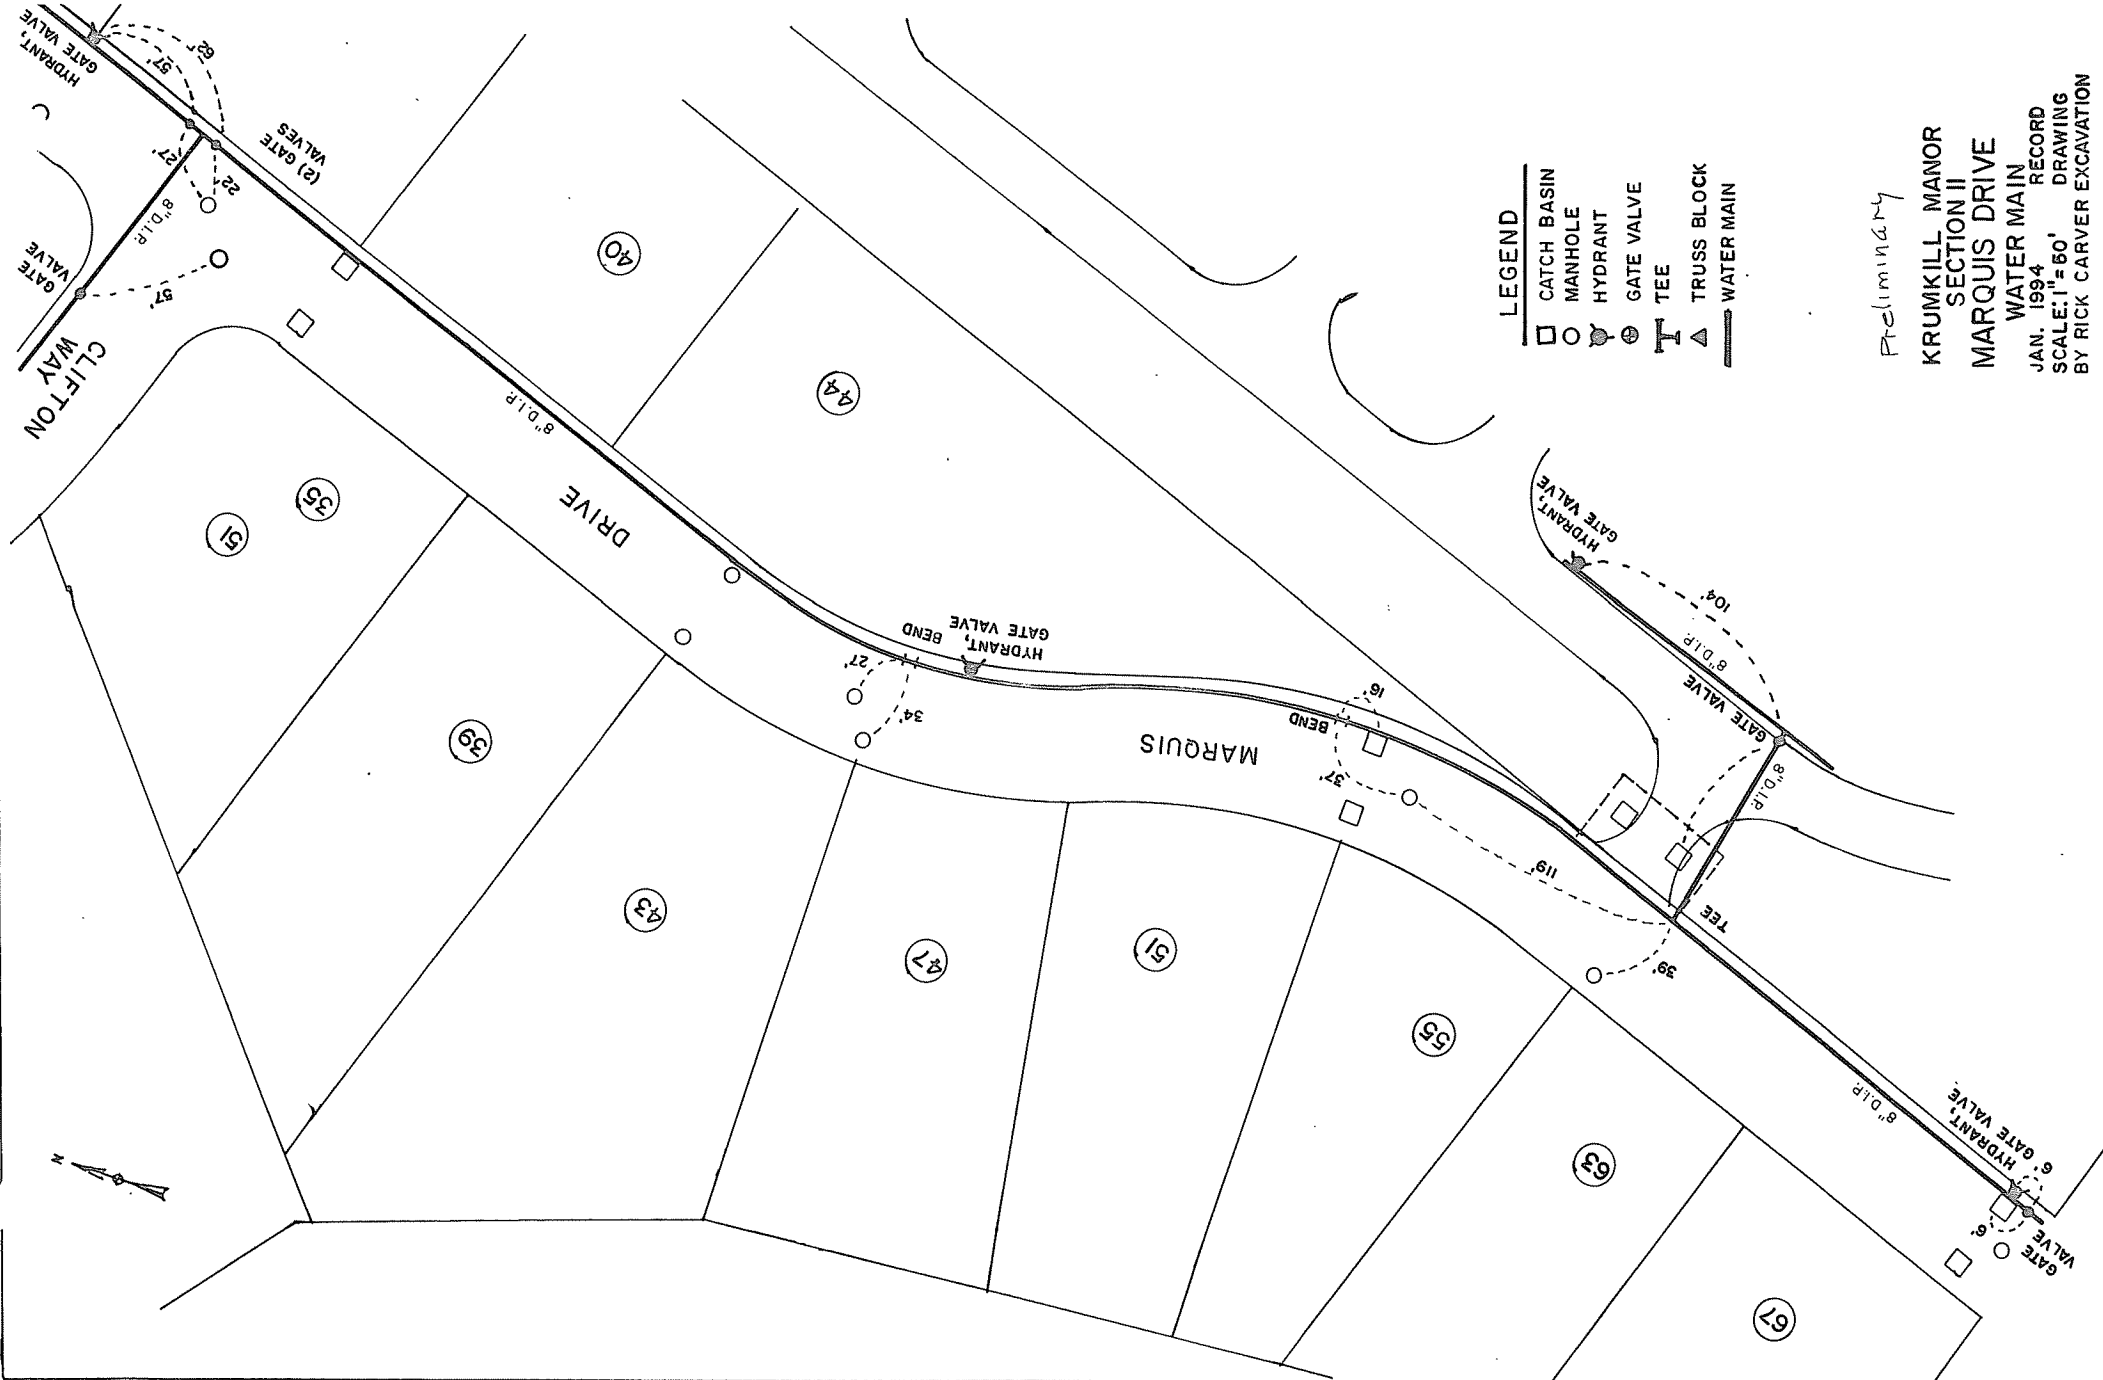

- LEGEND**
- CATCH BASIN
 - MANHOLE
 - ⊗ HYDRANT
 - ⊗ GATE VALVE
 - T TEE
 - △ TRUSS BLOCK
 - WATER MAIN

Preliminary

**KRUMKILL MANOR
SECTION II
MARQUIS DRIVE
WATER MAIN**

JAN. 1994 RECORD
SCALE: 1"=50'
DRAWING
BY RICK CARVER EXCAVATION