


CHARLES BUILDERS, DEVELOPER
RD 5, Box 437A
Scheneectady, New York 12306
Phone: (518) 355-7083
Fax: (518) 355-6991



CHARLES BUILDERS, DEVELOPER
RD 5, Box 437A
Scheneectady, New York 12306
Phone: (518) 355-7083

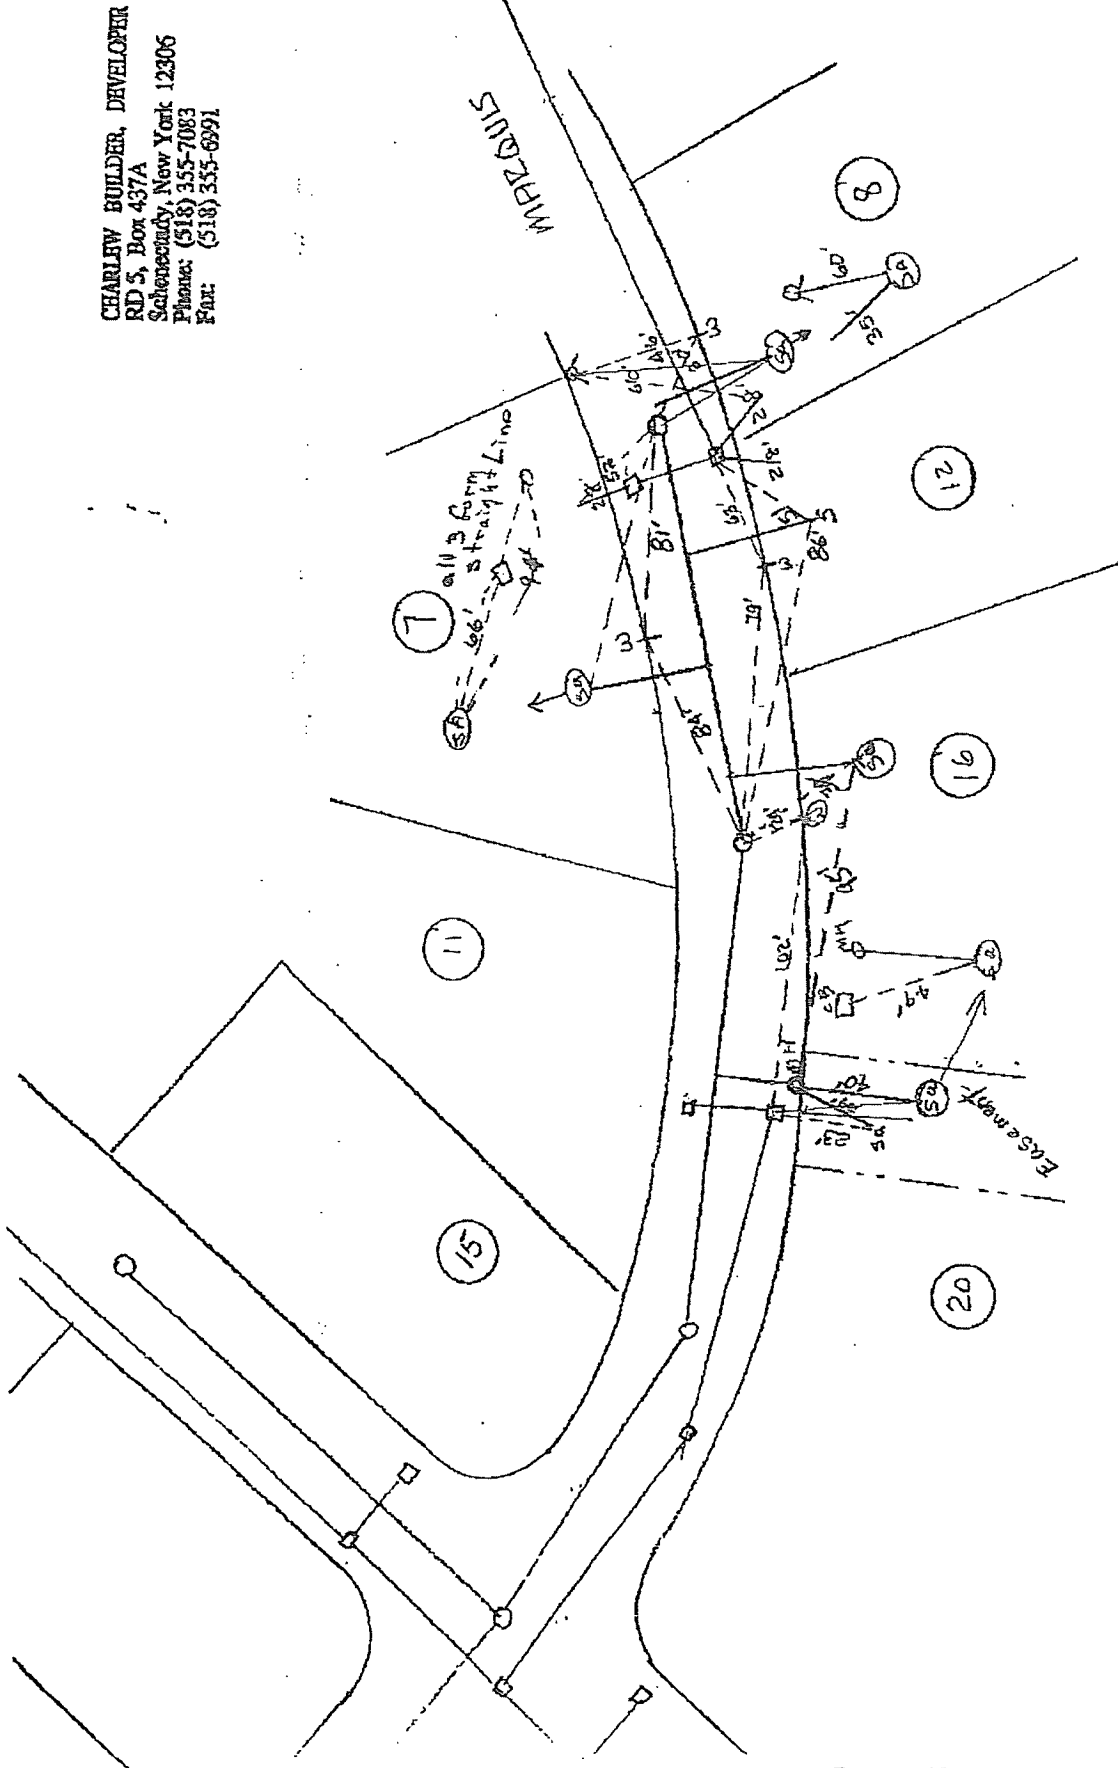