


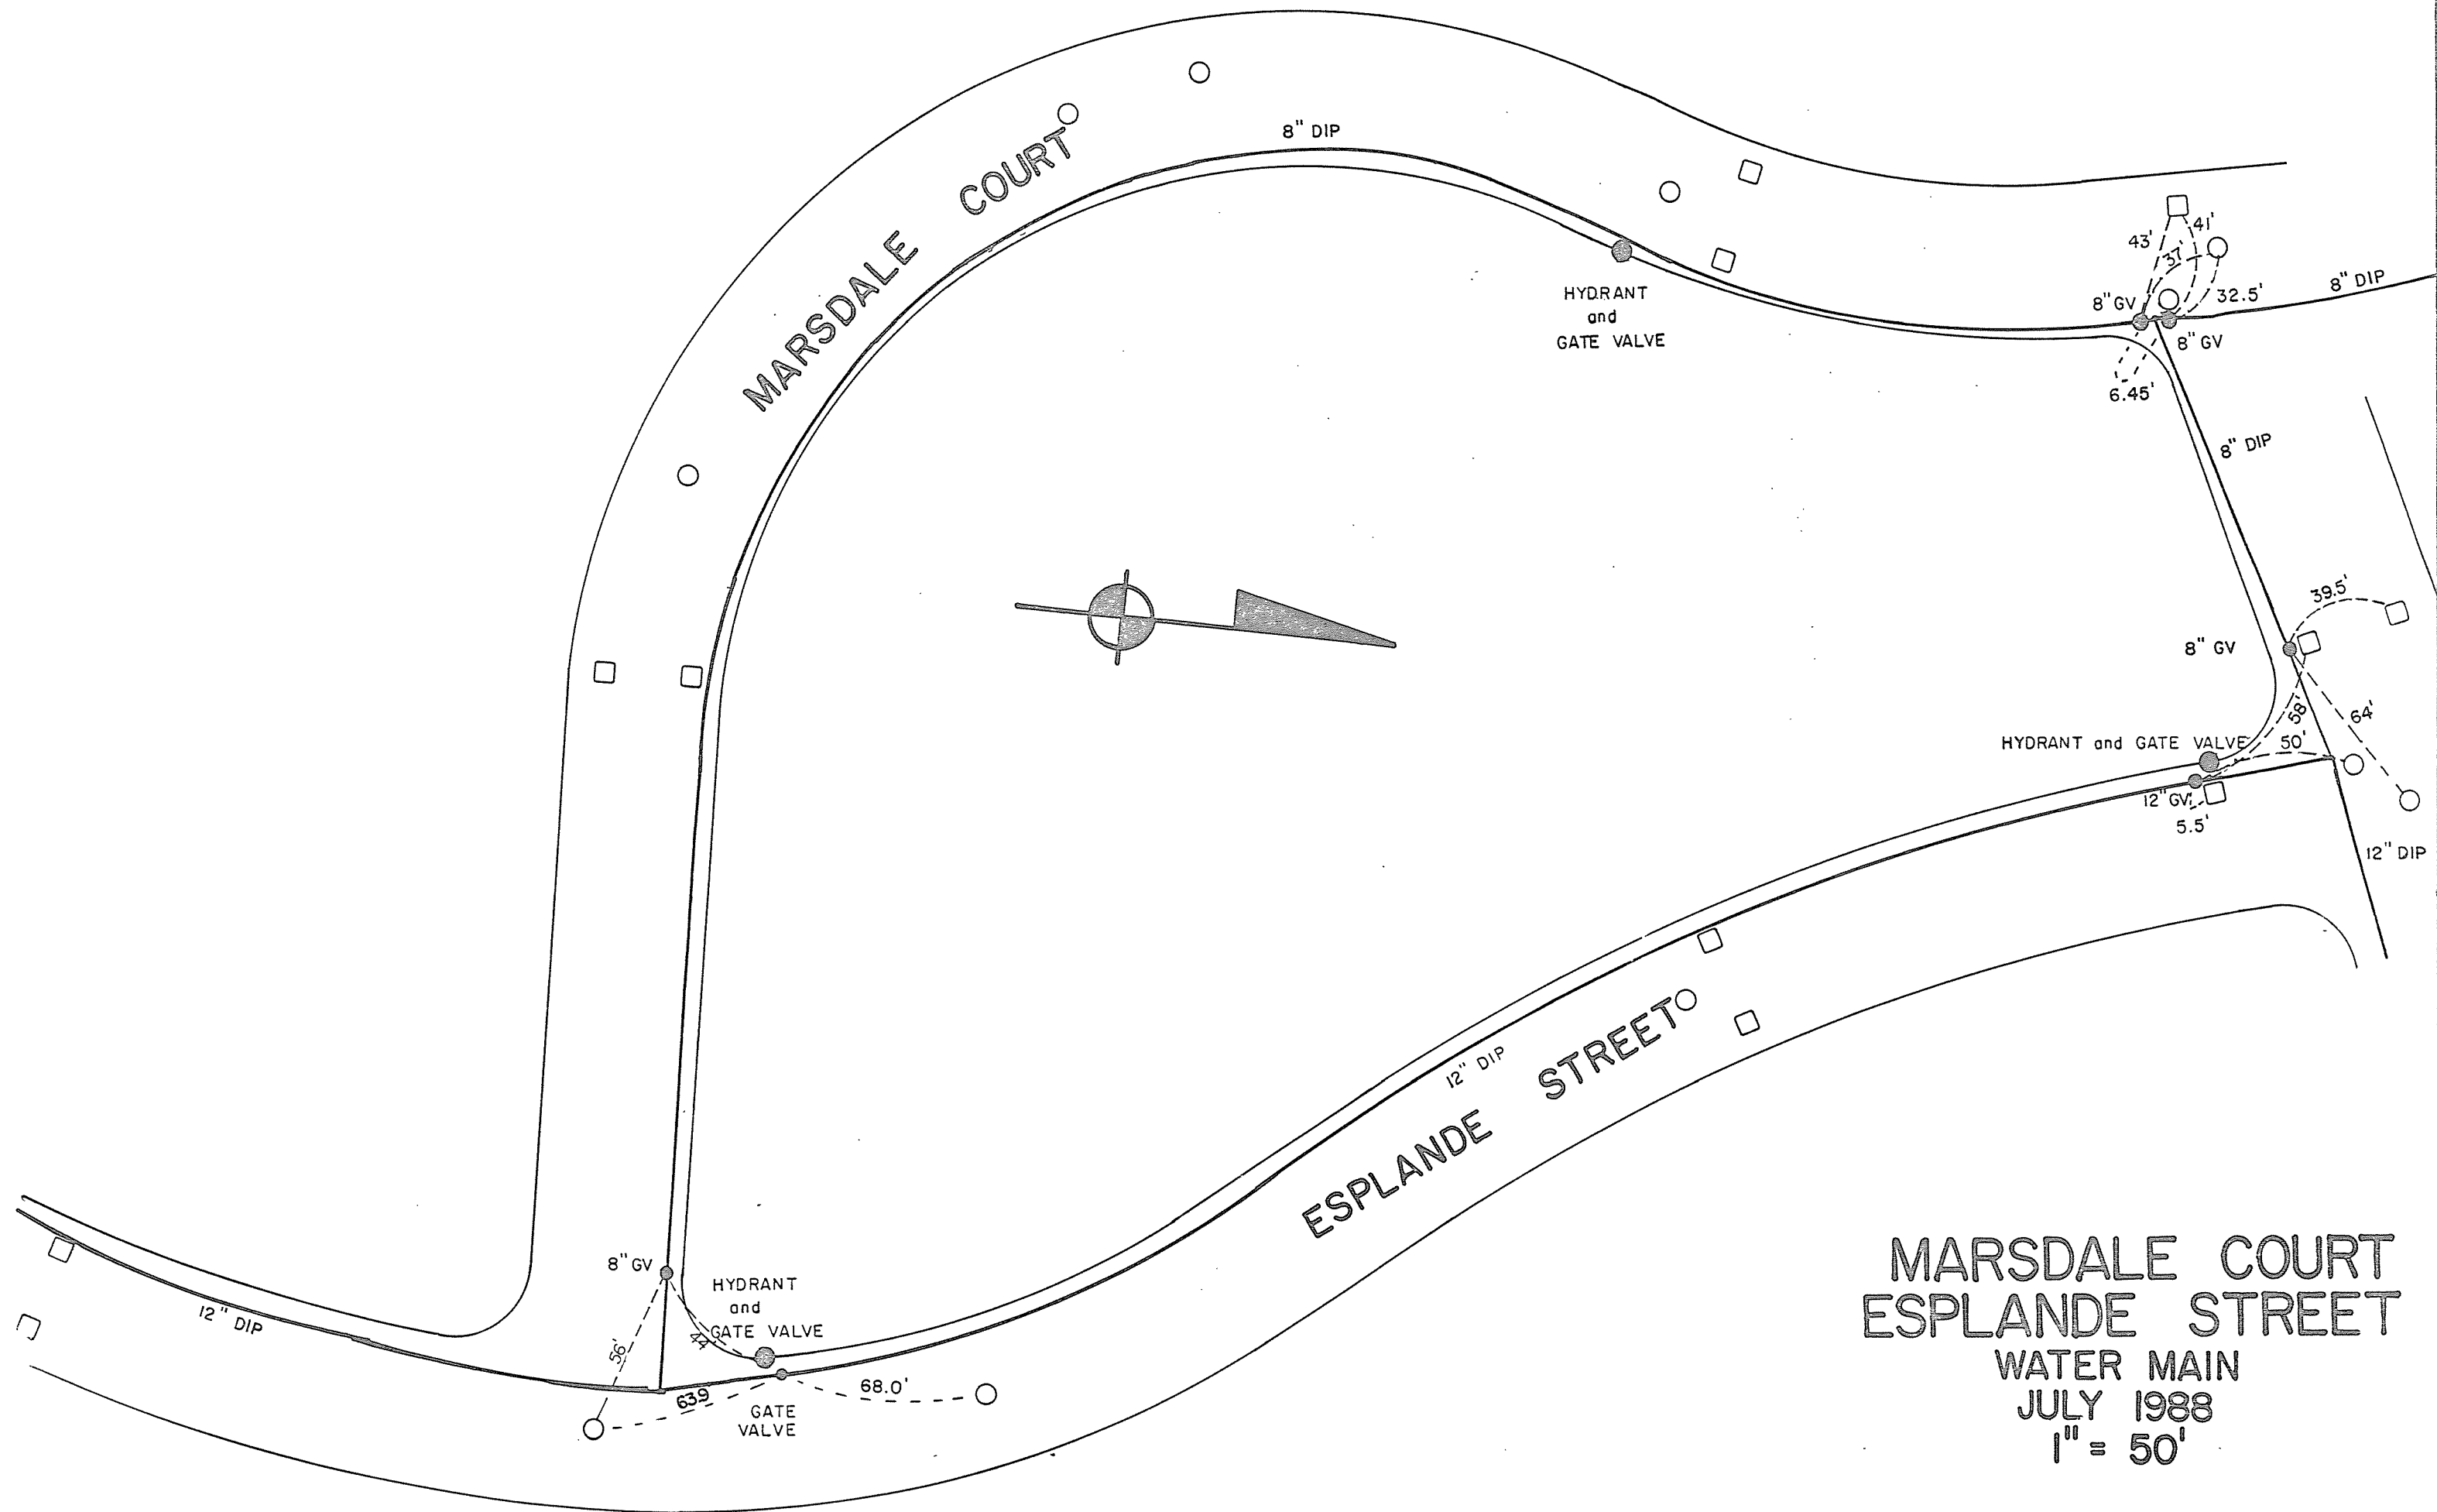

MARSDALE COURT
ESPLANDE STREET
WATER MAIN
JULY 1988
1" = 50'