


# LEGEND

- CATCH BASIN
- MANHOLE
- HYDRANT
- ⊕ GATE VALVE
- ⊥ TEE
- ▲ THRUST BLOCK
- W — WATER MAIN

## NOTE:

ALL MAINS SHALL BE DUCTILE IRON  
SIZE AS NOTED.

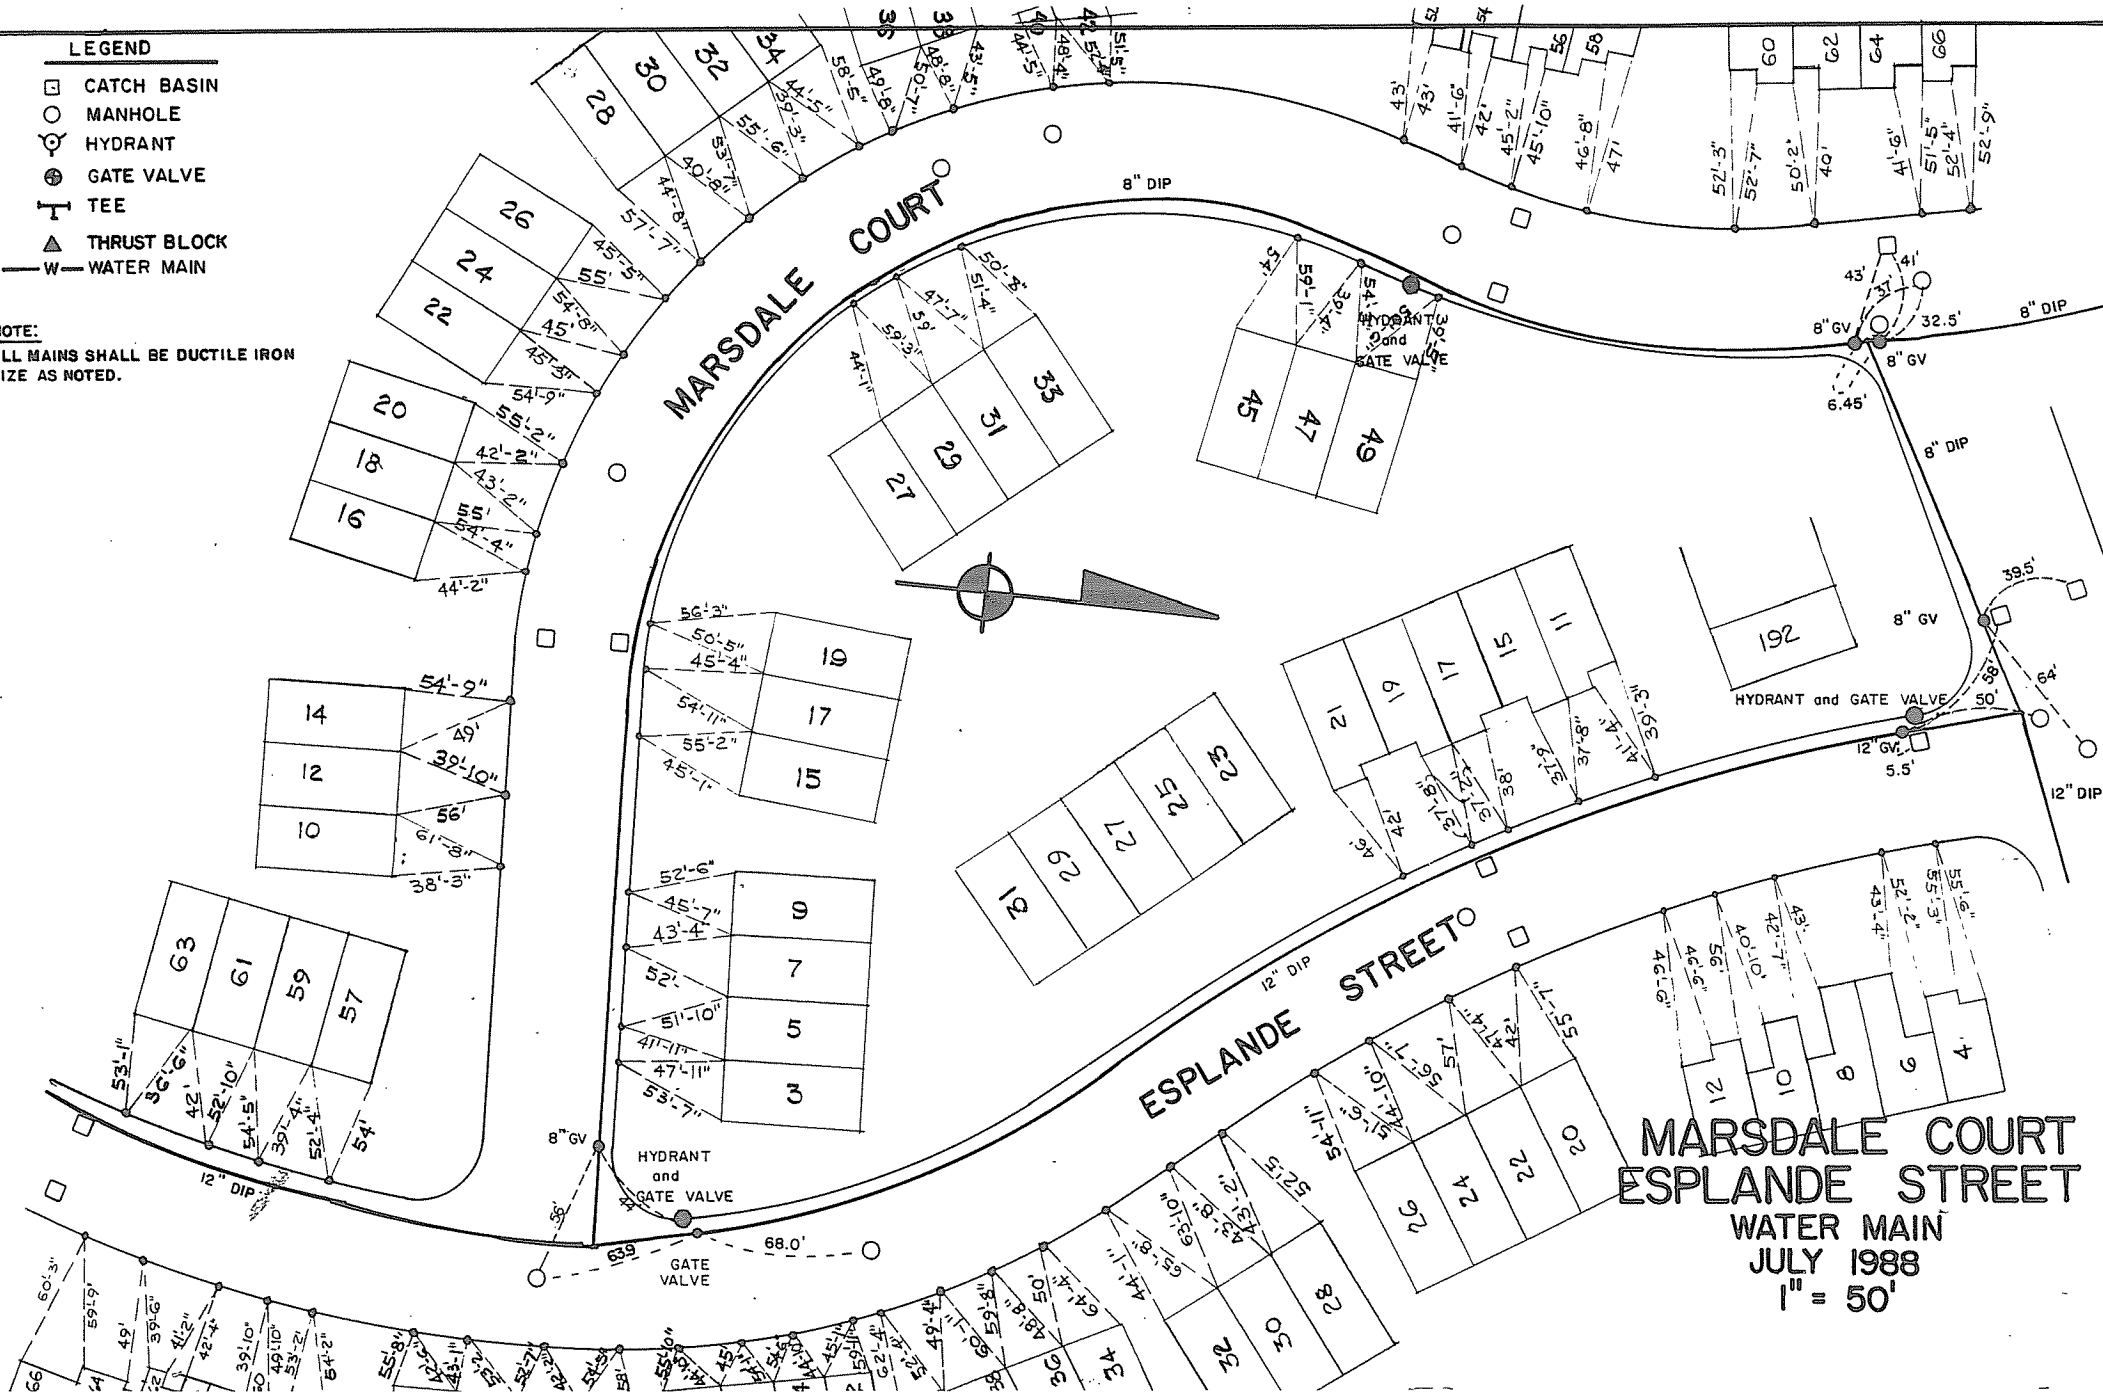

**MARSDALE COURT  
ESPLANDE STREET**  
WATER MAIN  
JULY 1988  
1" = 50'