


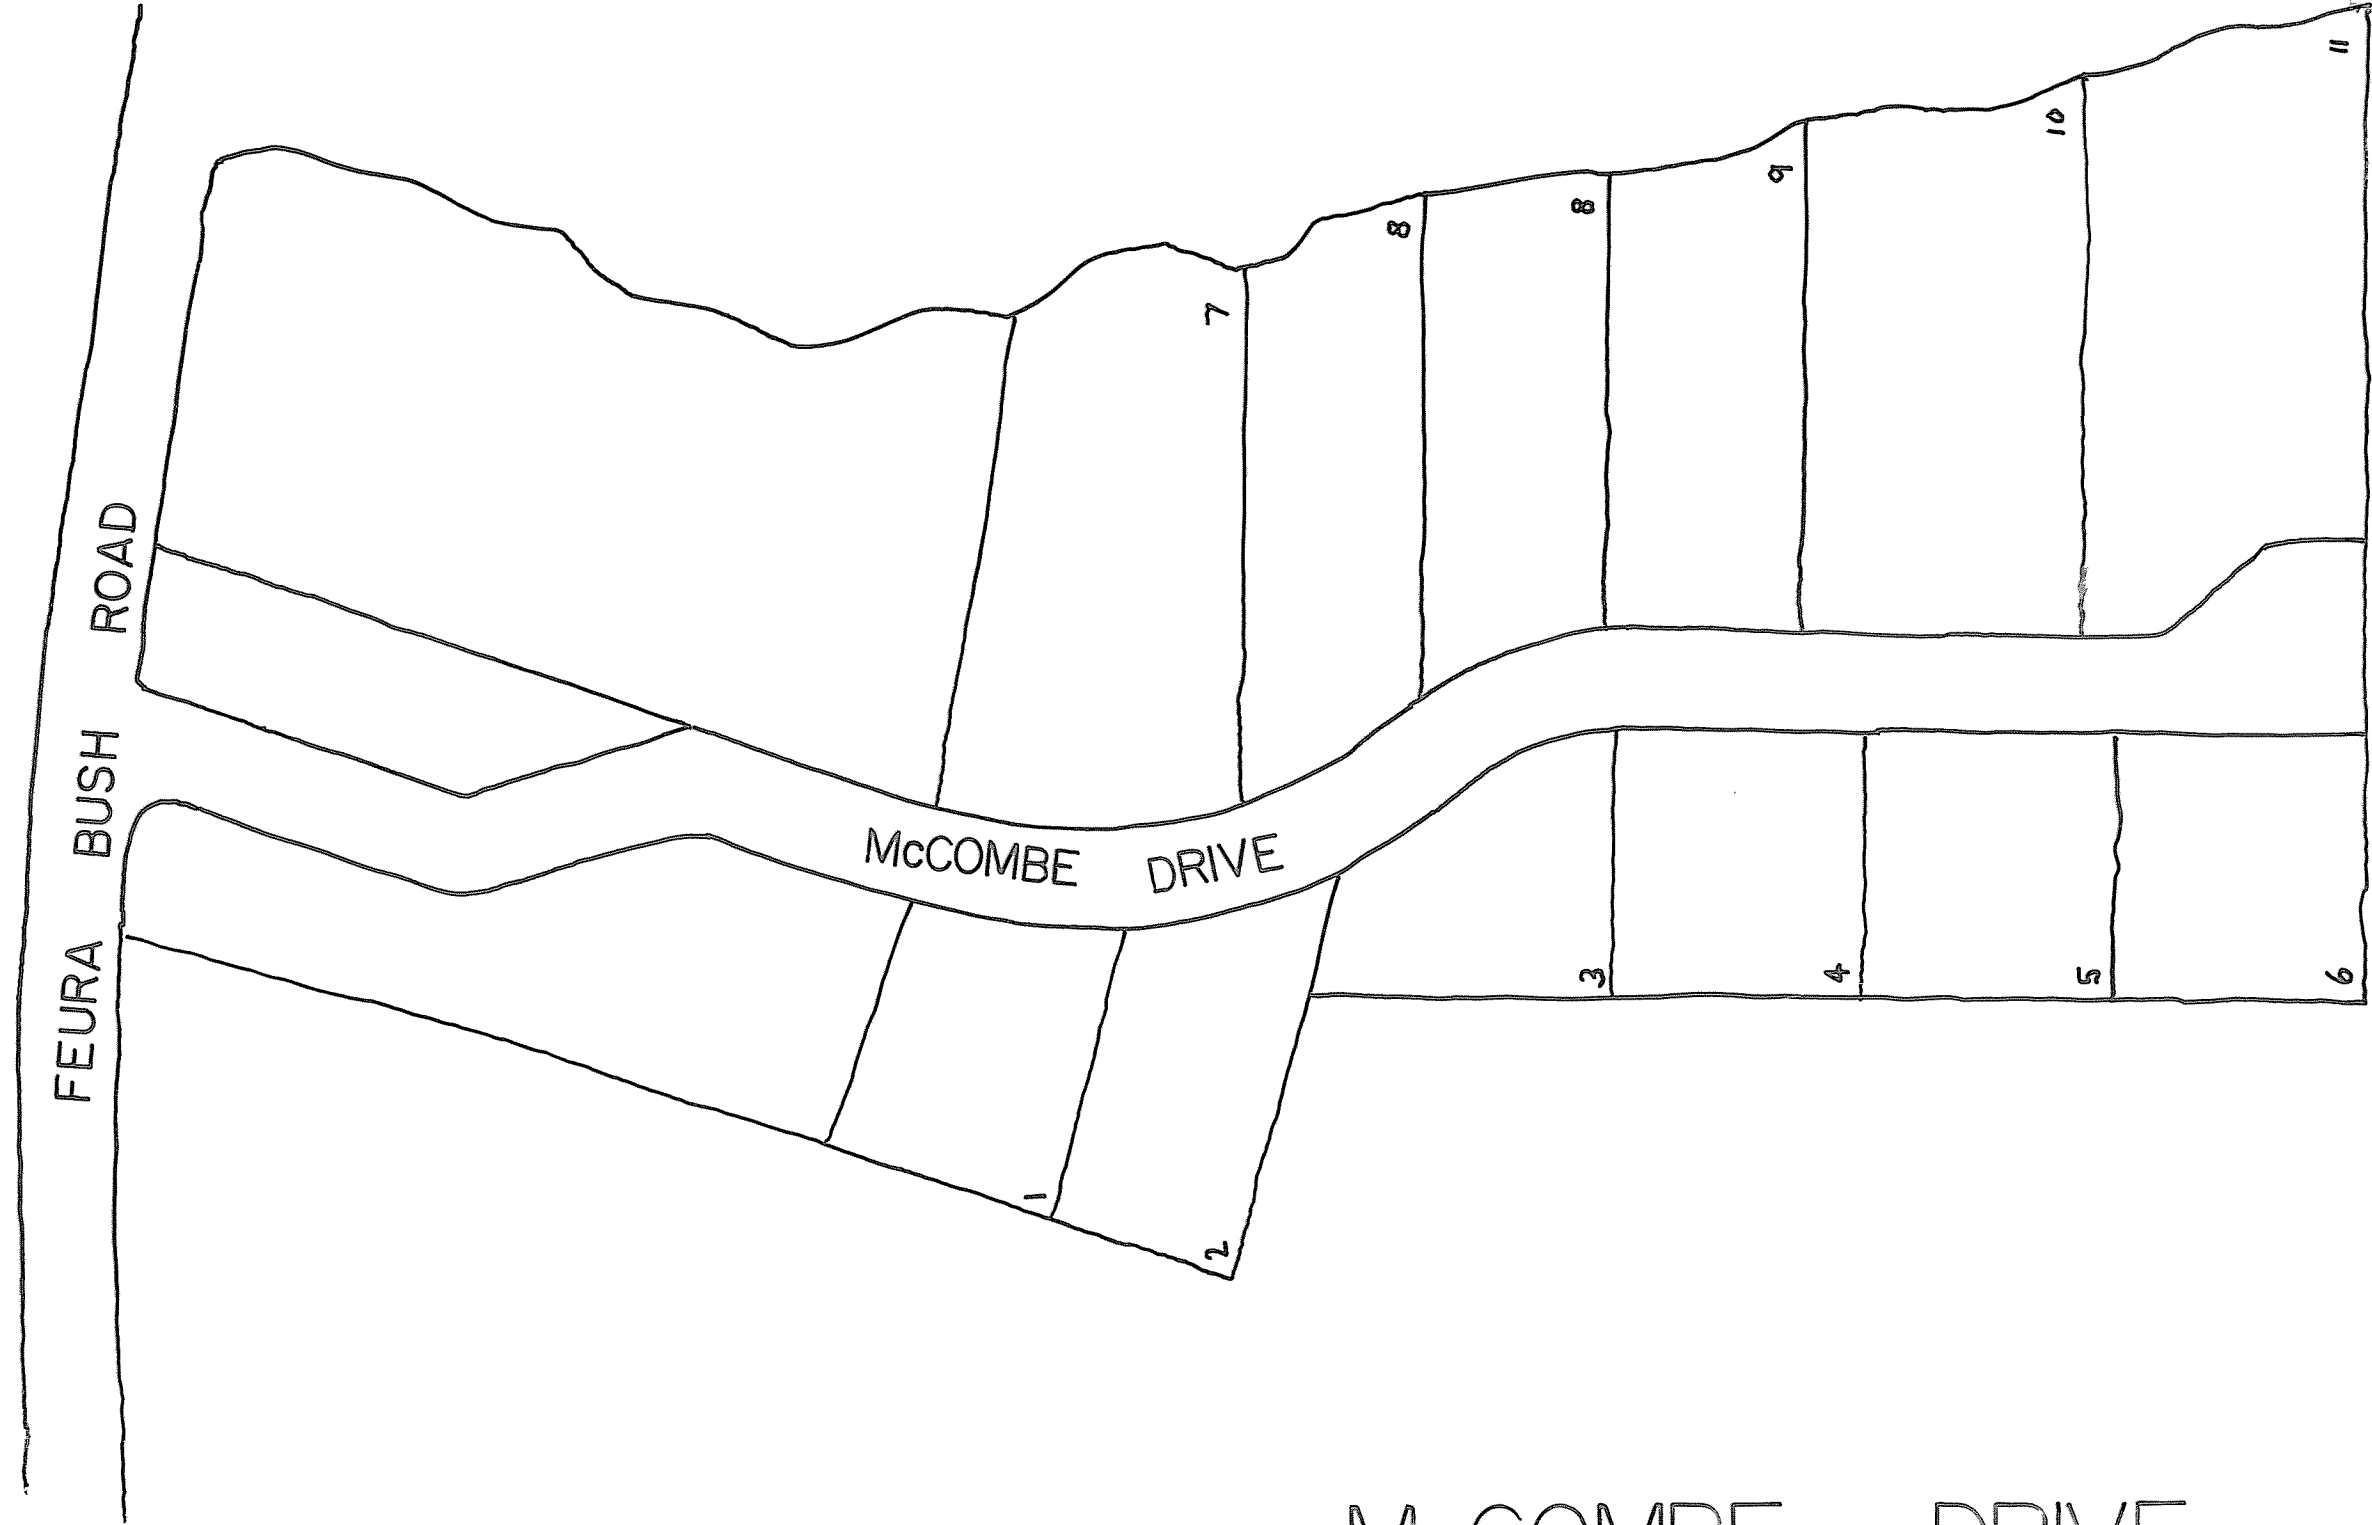

McCOMBE DRIVE