


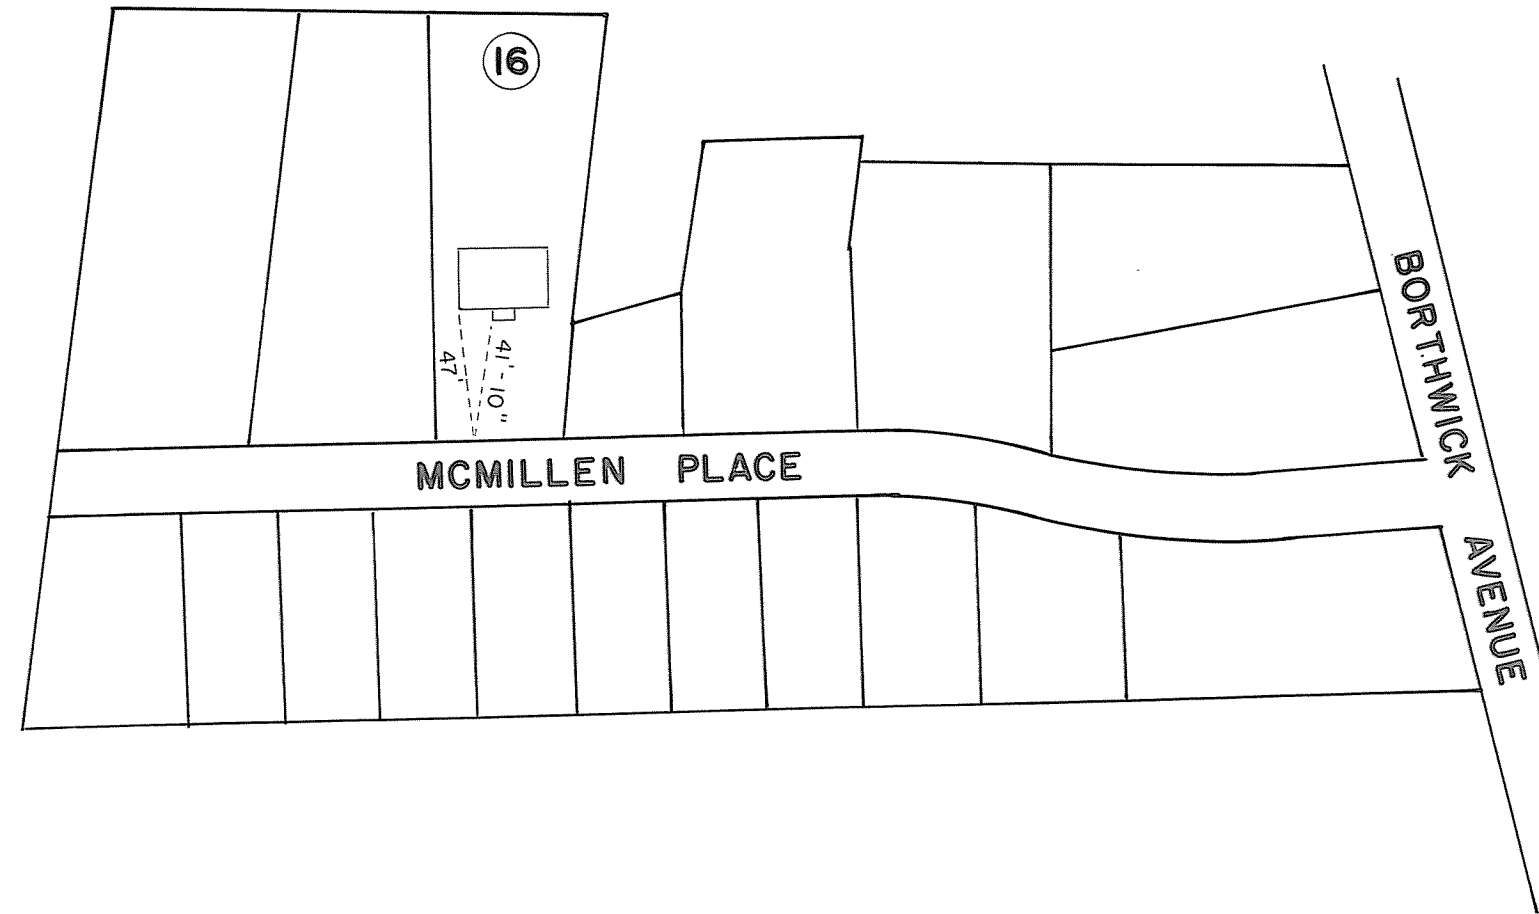

McMILLEN PLACE