


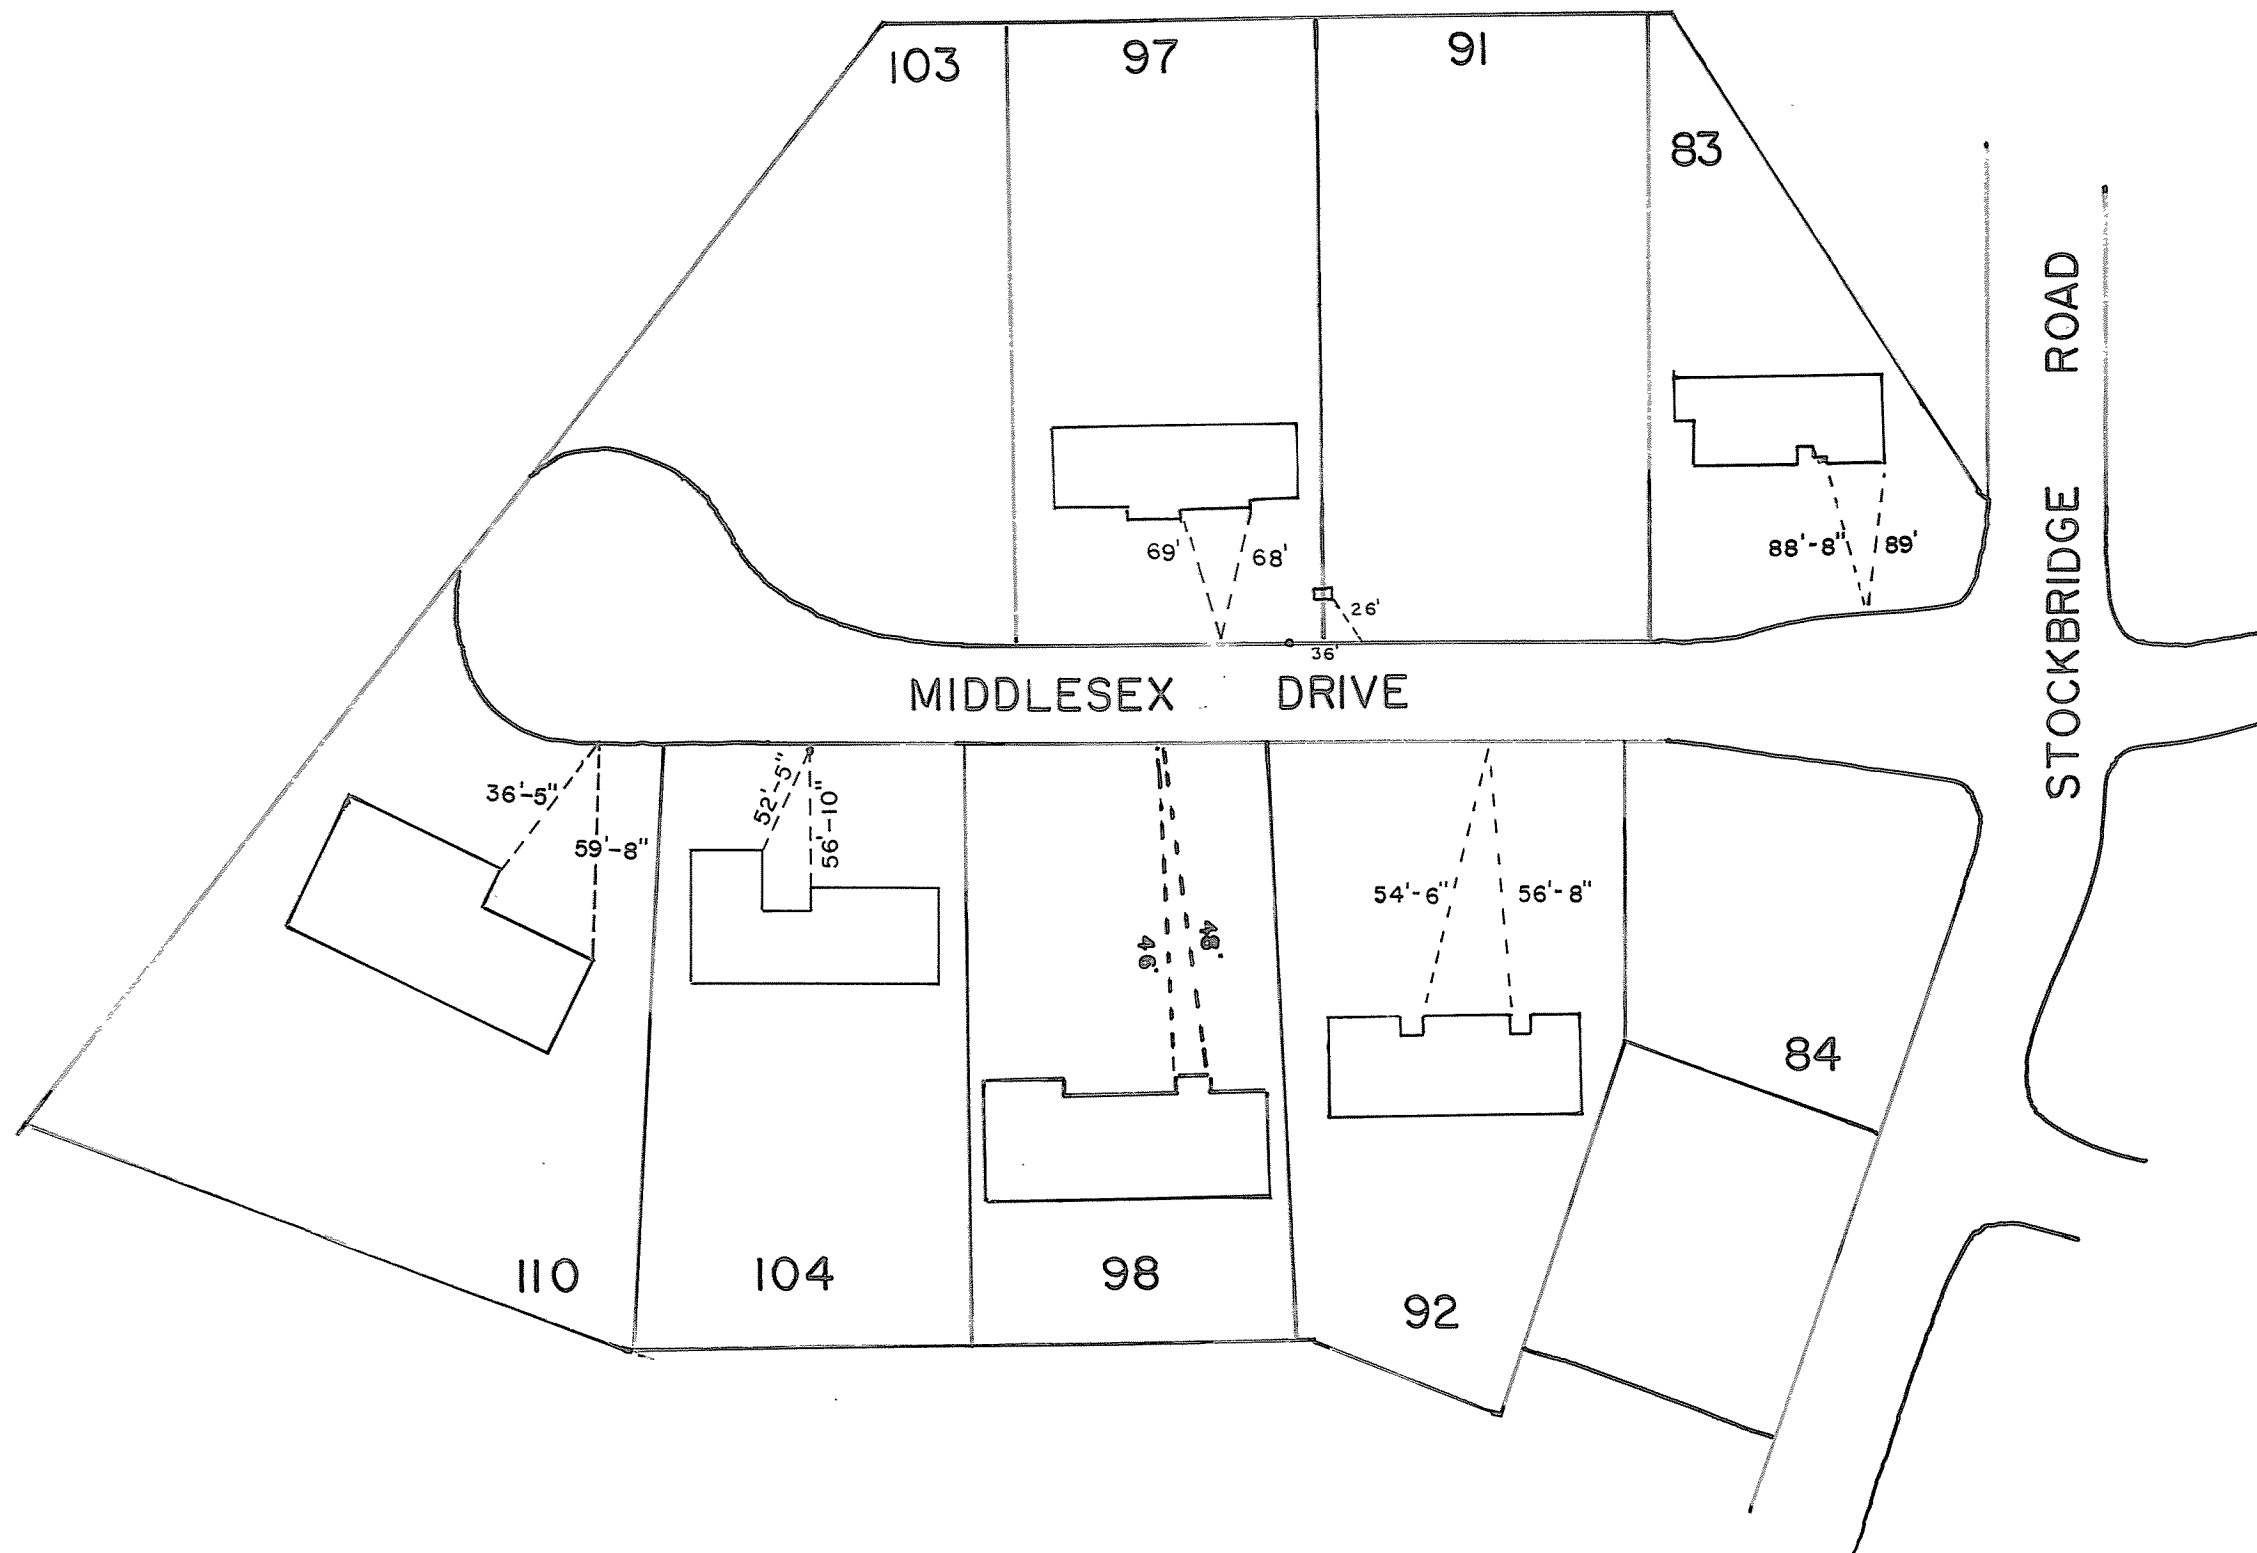

MIDDLESEX DRIVE