



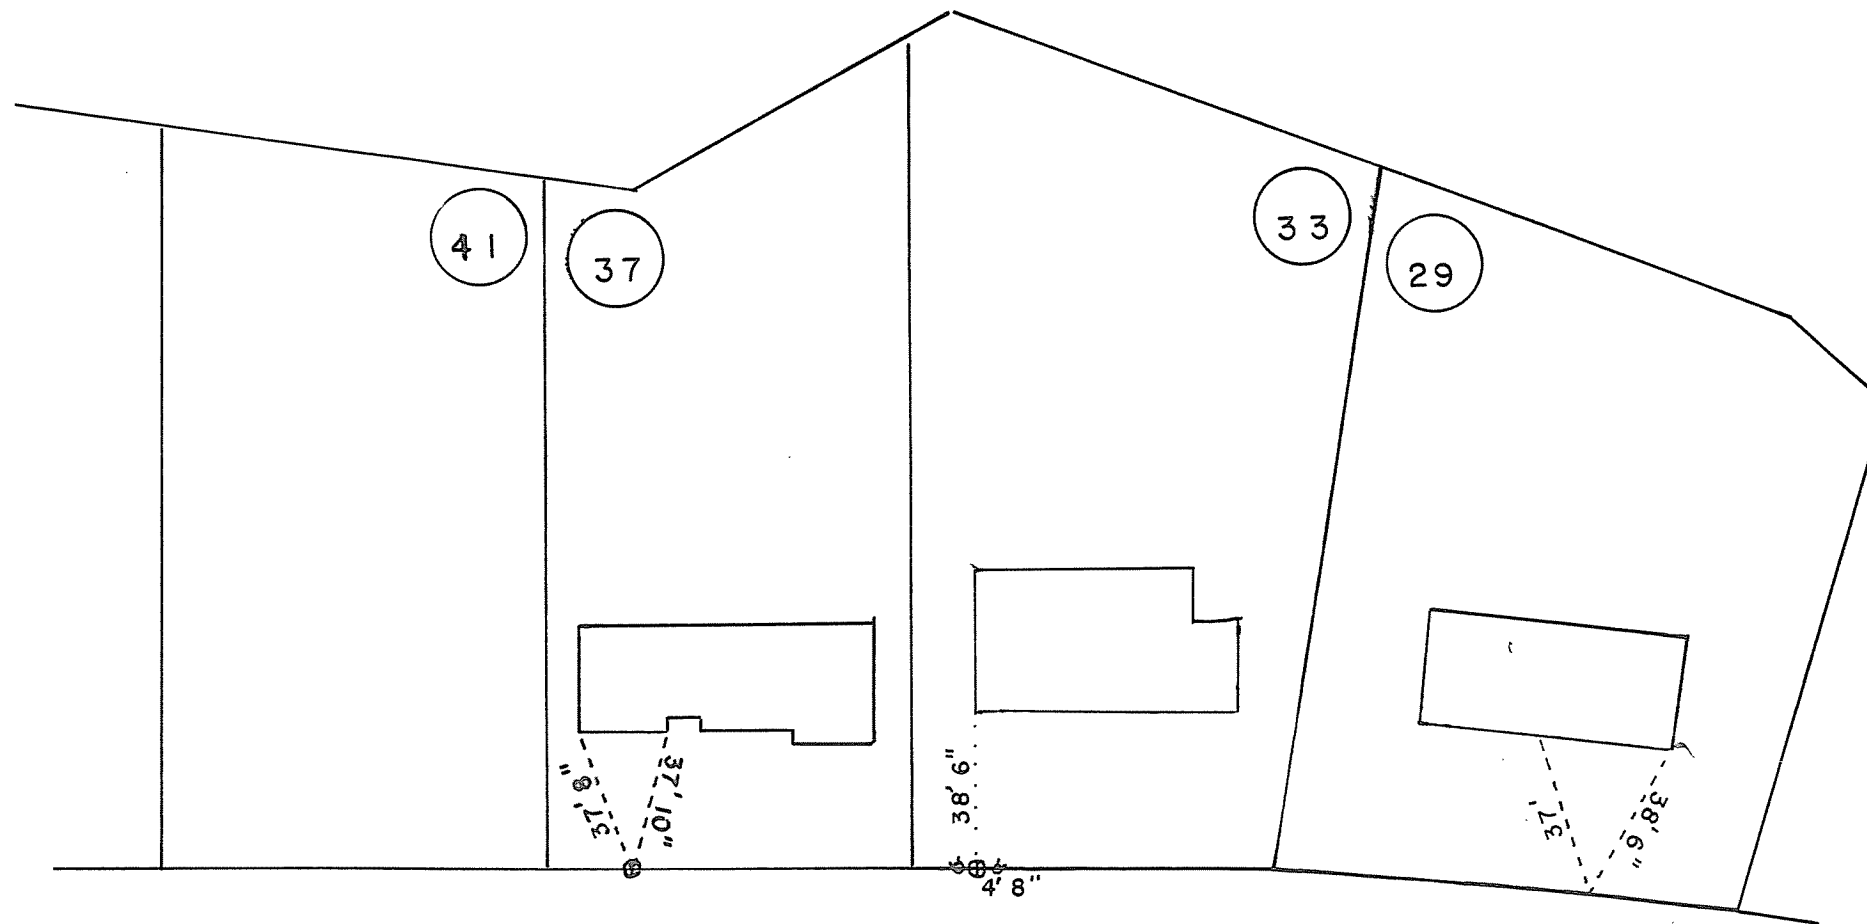

MIDDLESEX DRIVE

Middlesex Drive

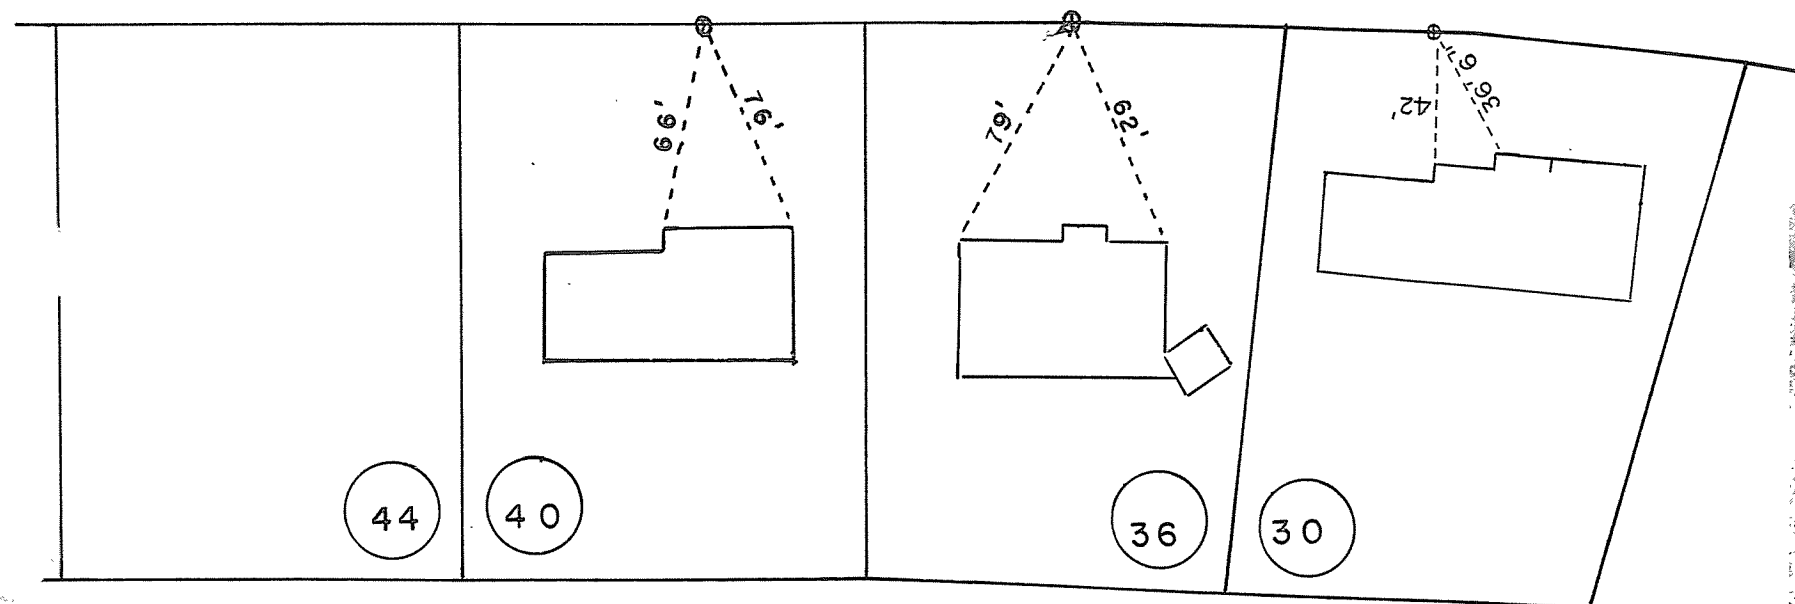

SCALE 1" = 50'	
DRAWN BY REB	
APPROVED	
DATE	
	TOWN OF BELLEVILLE
	ENGINEER - CIVIL
	1005 DELAWARE AVE. BELLEVILLE, NEW YORK 12220