

# MIDDLESEX DRIVE

WATER DISTRICT NO. 1

TOWN OF BETHLEHEM


## RECORD OF INSTALLATION

TOWN OF BETHLEHEM ENGINEERING DEPARTMENT

SCALE: 1" = 50'

JUNE, 1984

DWNS. BY: KT

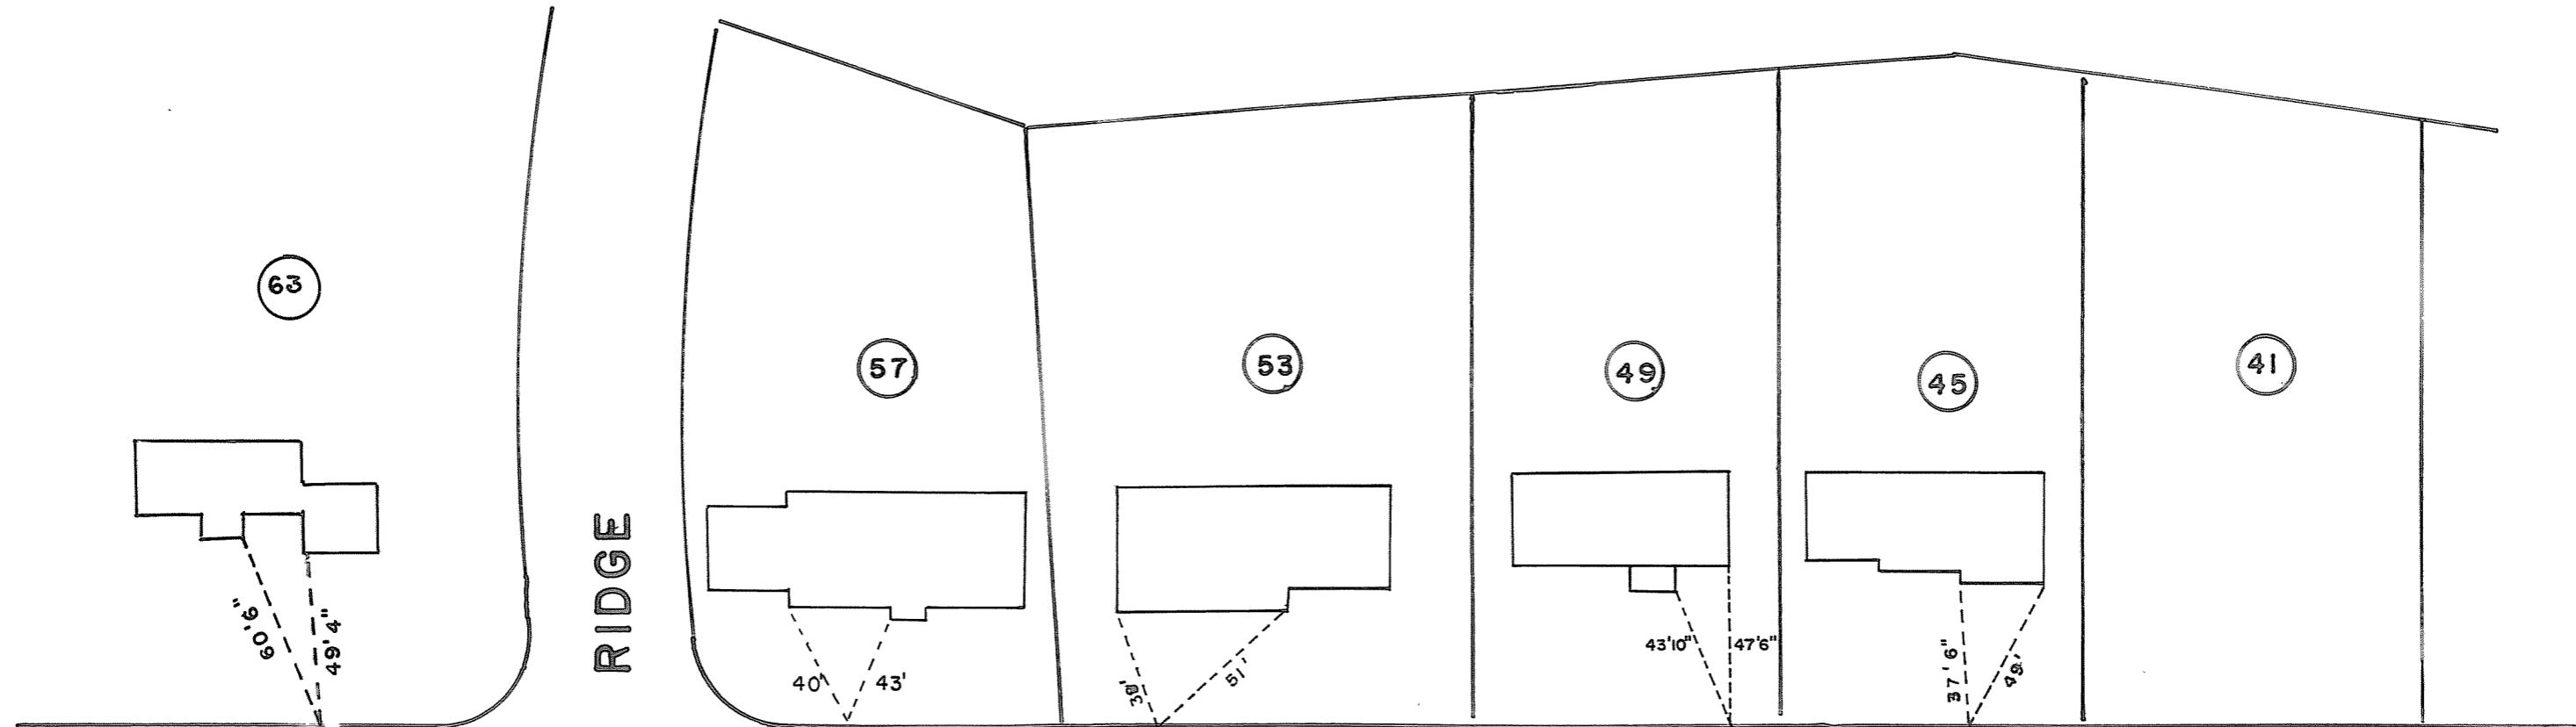

## MIDDLESEX

## DRIVE

