


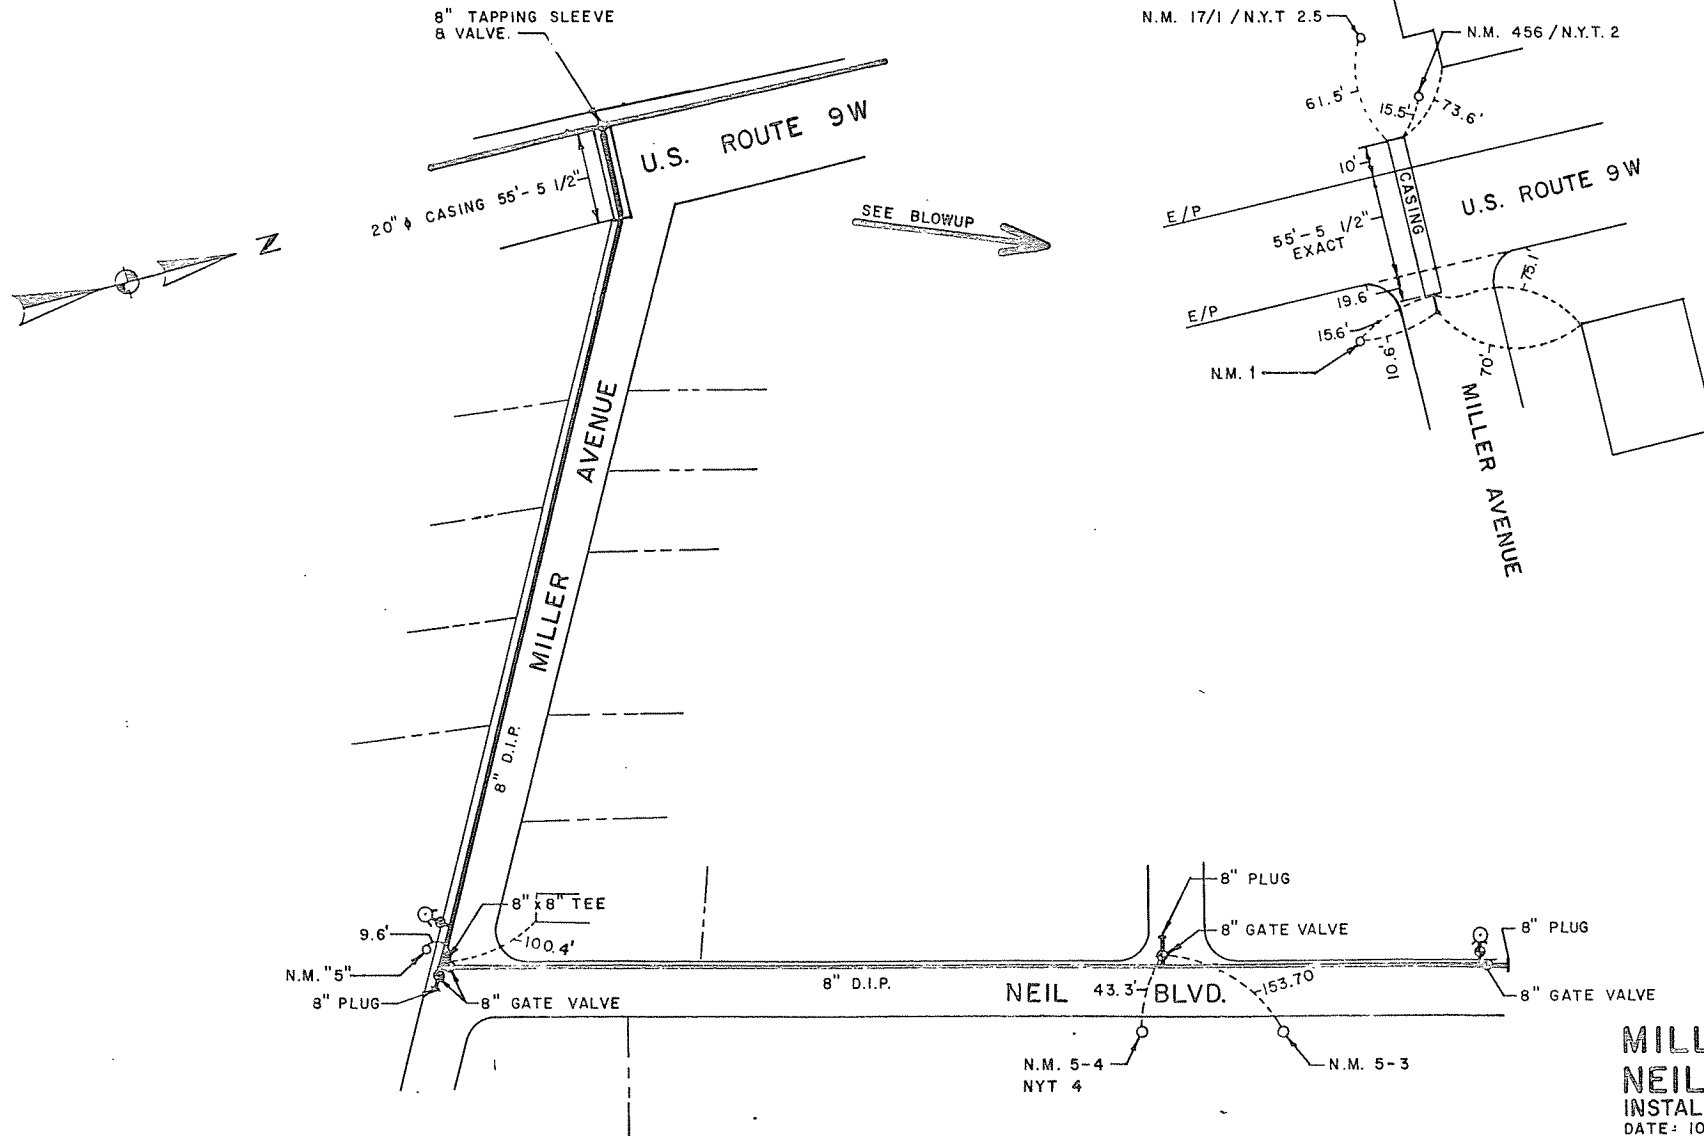

**MILLER AVE.
NEIL BLVD.**
INSTALLED BY THE T.O.B
DATE: 10/83
SCALE: N.T.S.