


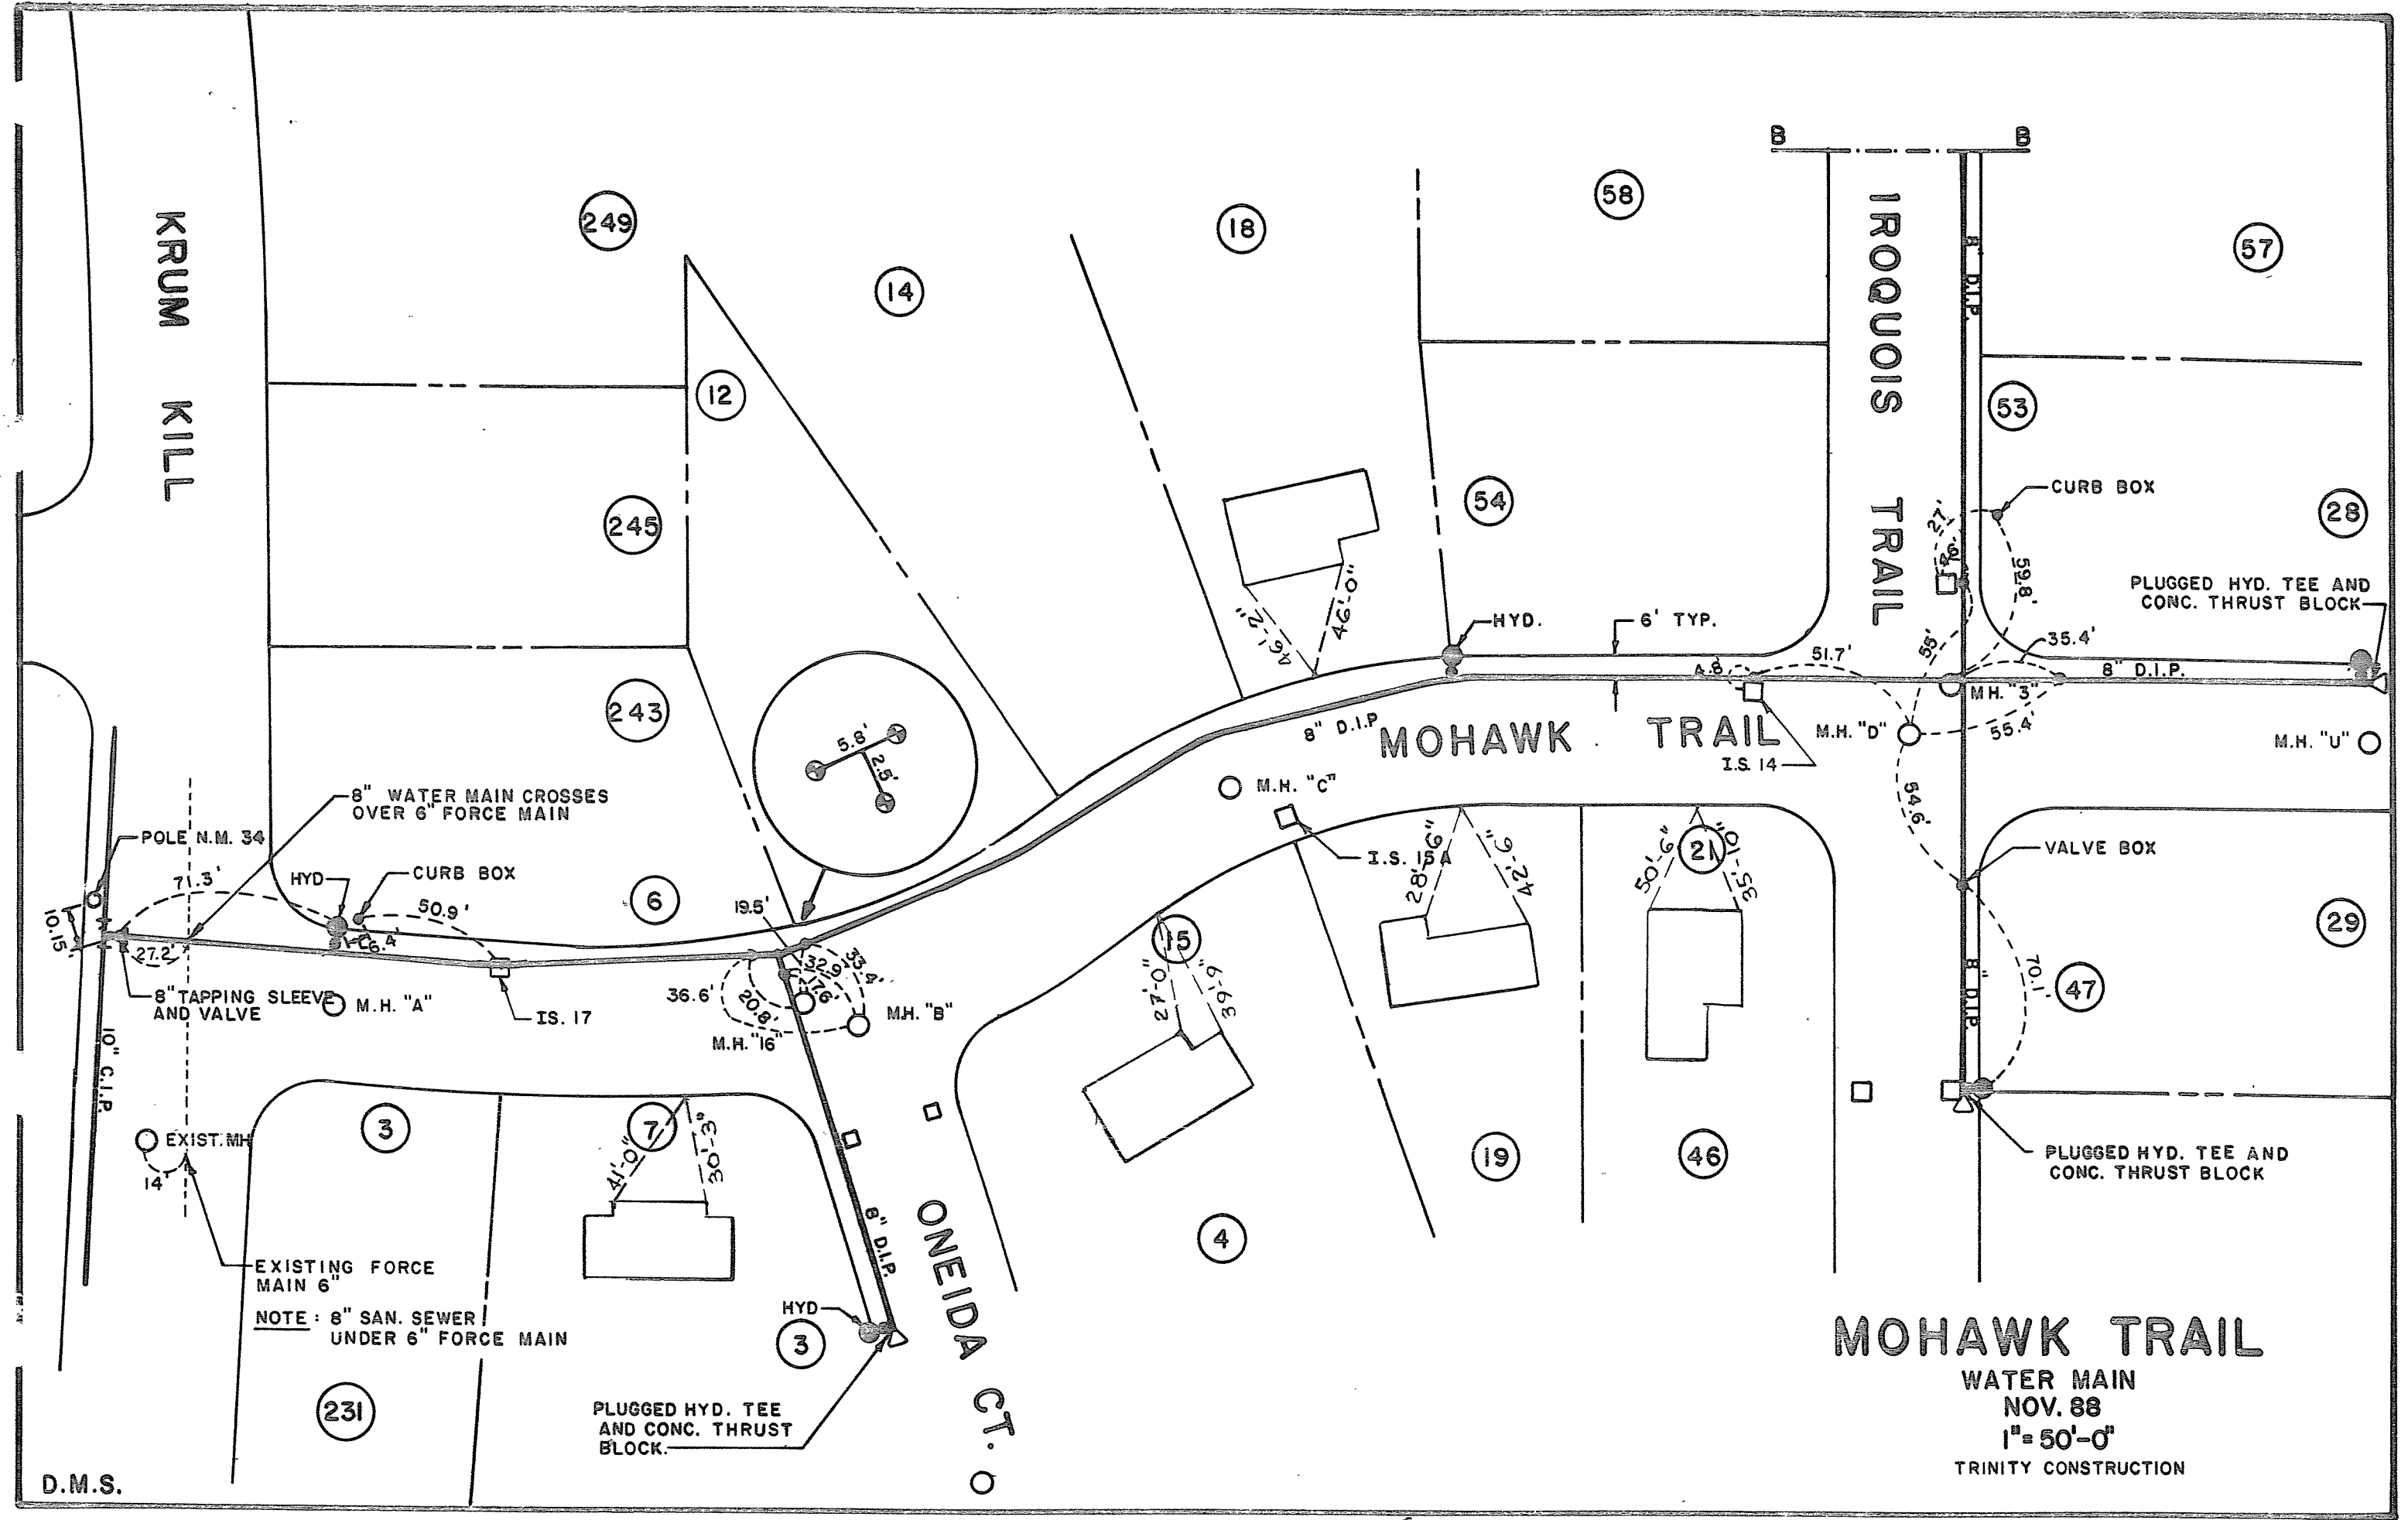

**MOHAWK TRAIL**

WATER MAIN  
NOV. 88

1" = 50'-0"

TRINITY CONSTRUCTION

D.M.S.