


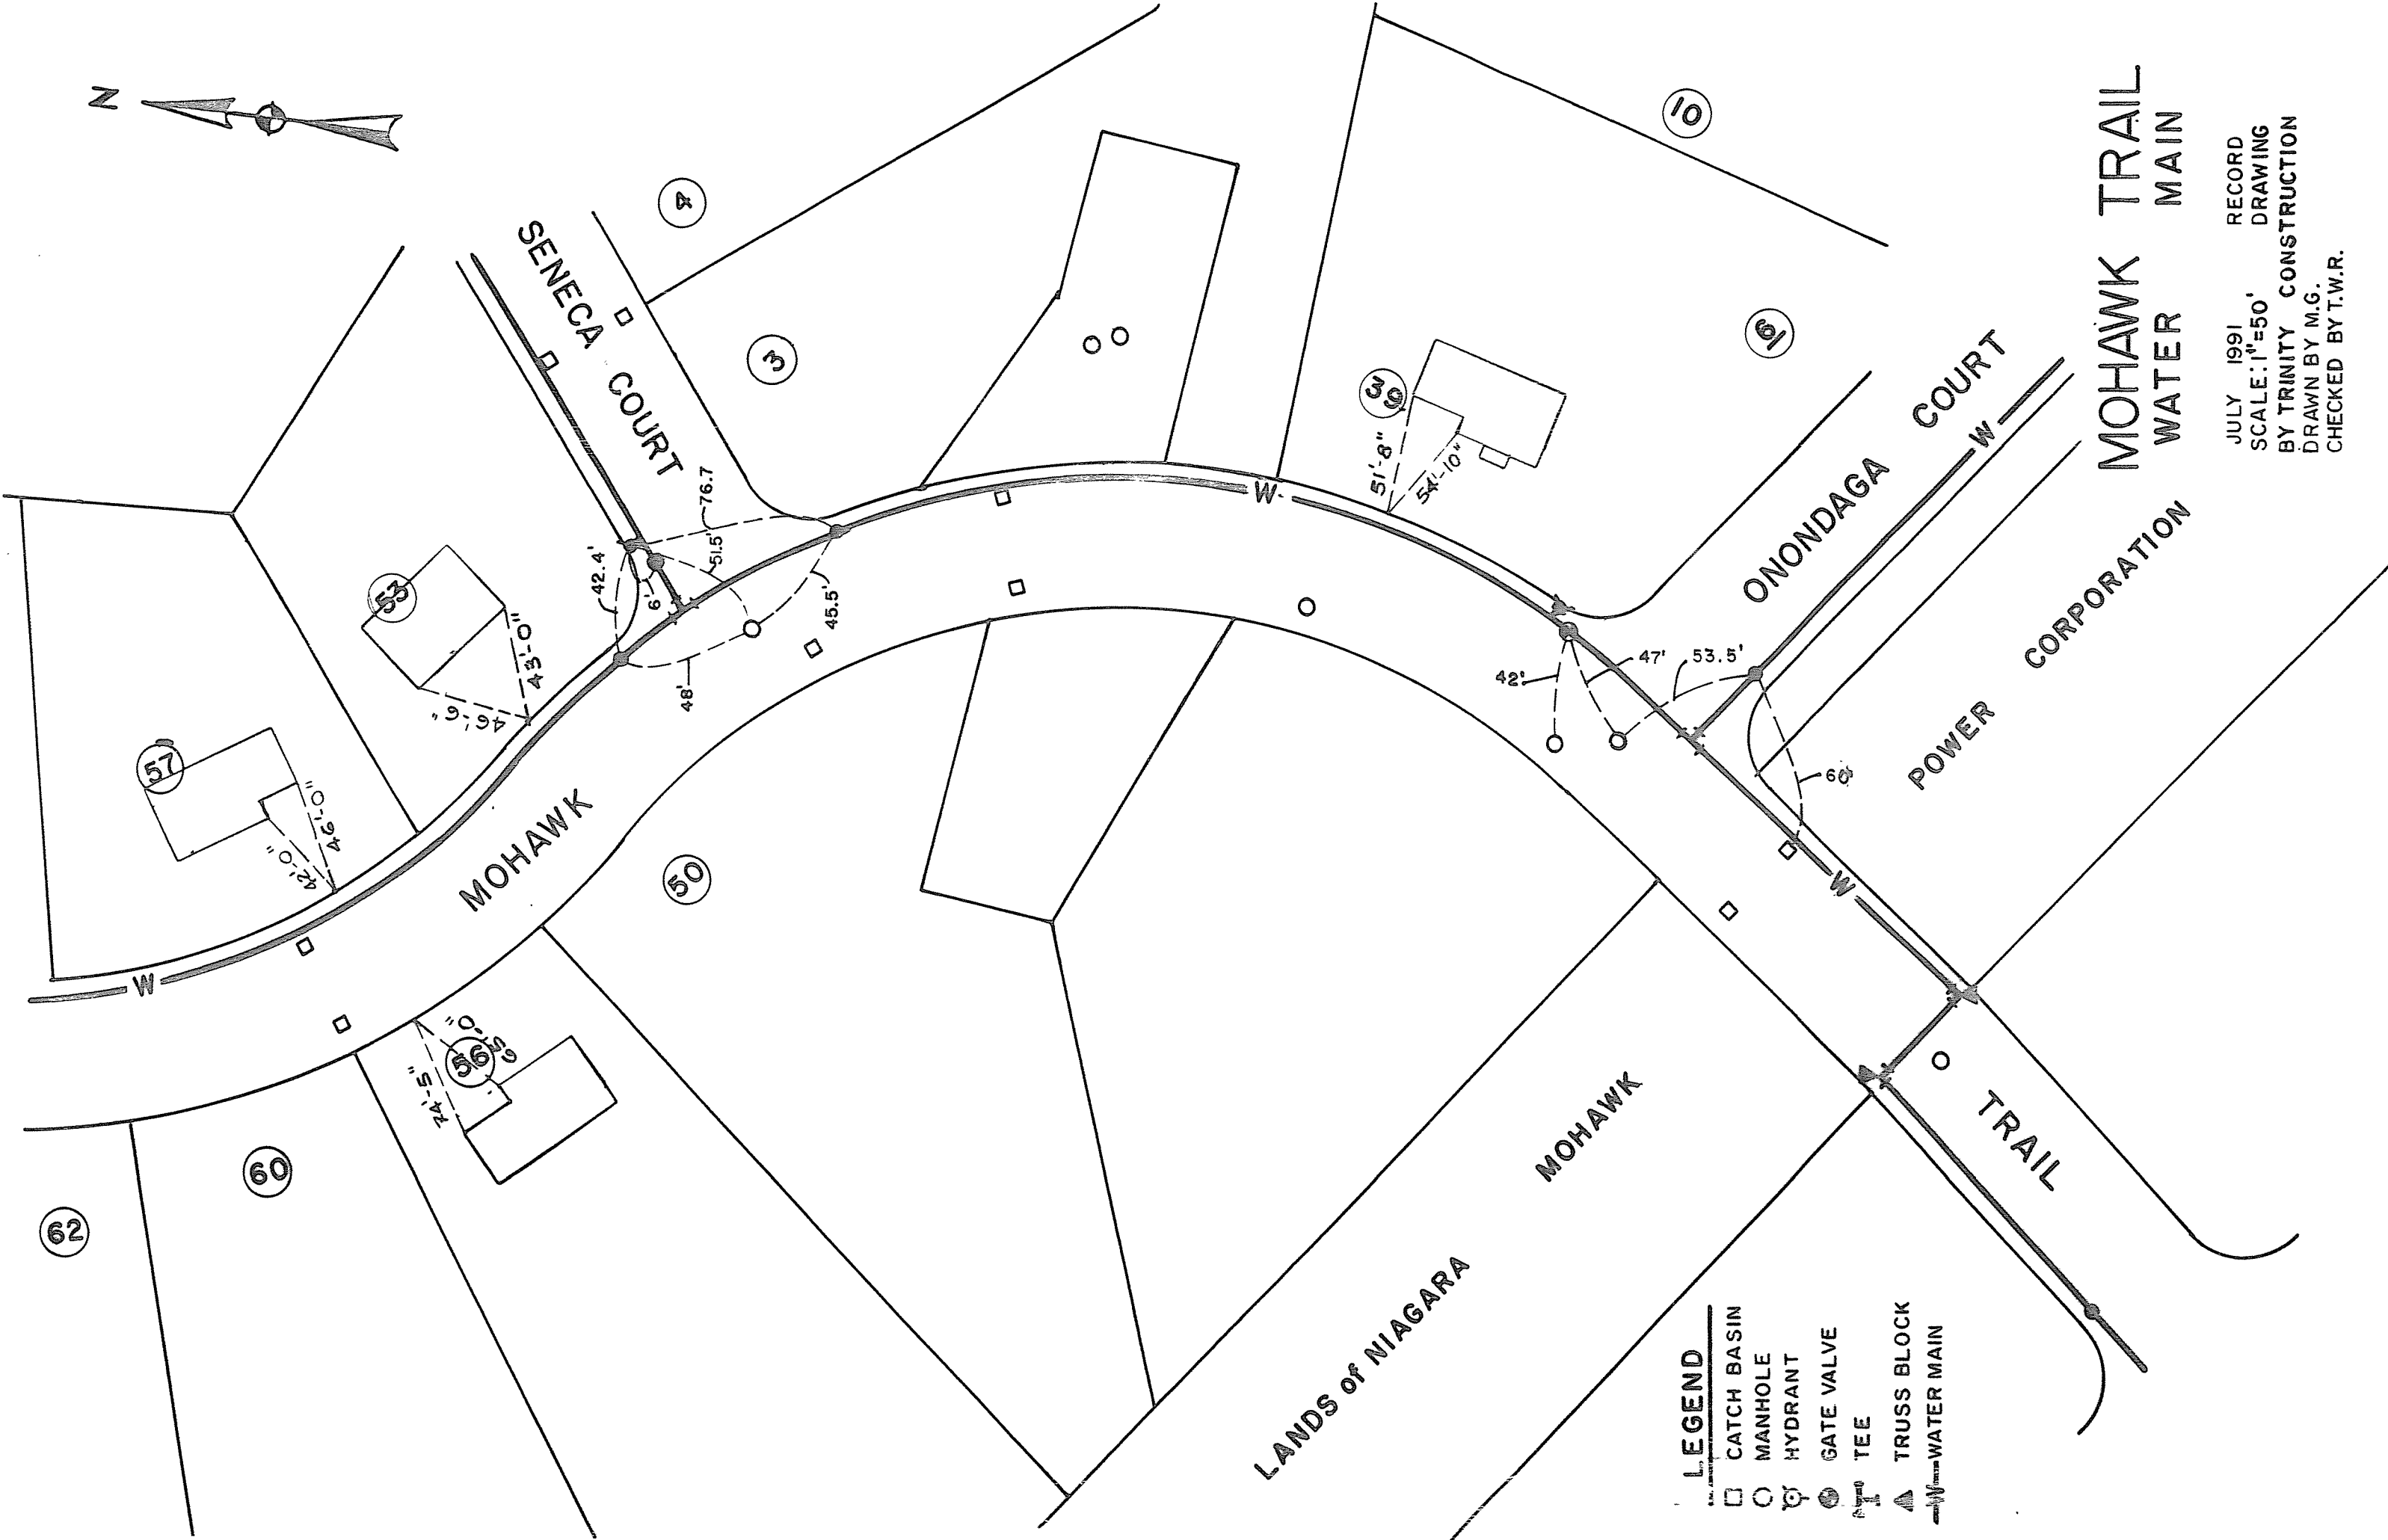

MOHAWK TRAIL
WATER MAIN

JULY 1991 RECORD
SCALE: 1"=50' DRAWING
BY TRINITY CONSTRUCTION
DRAWN BY M.G.
CHECKED BY T.W.R.