


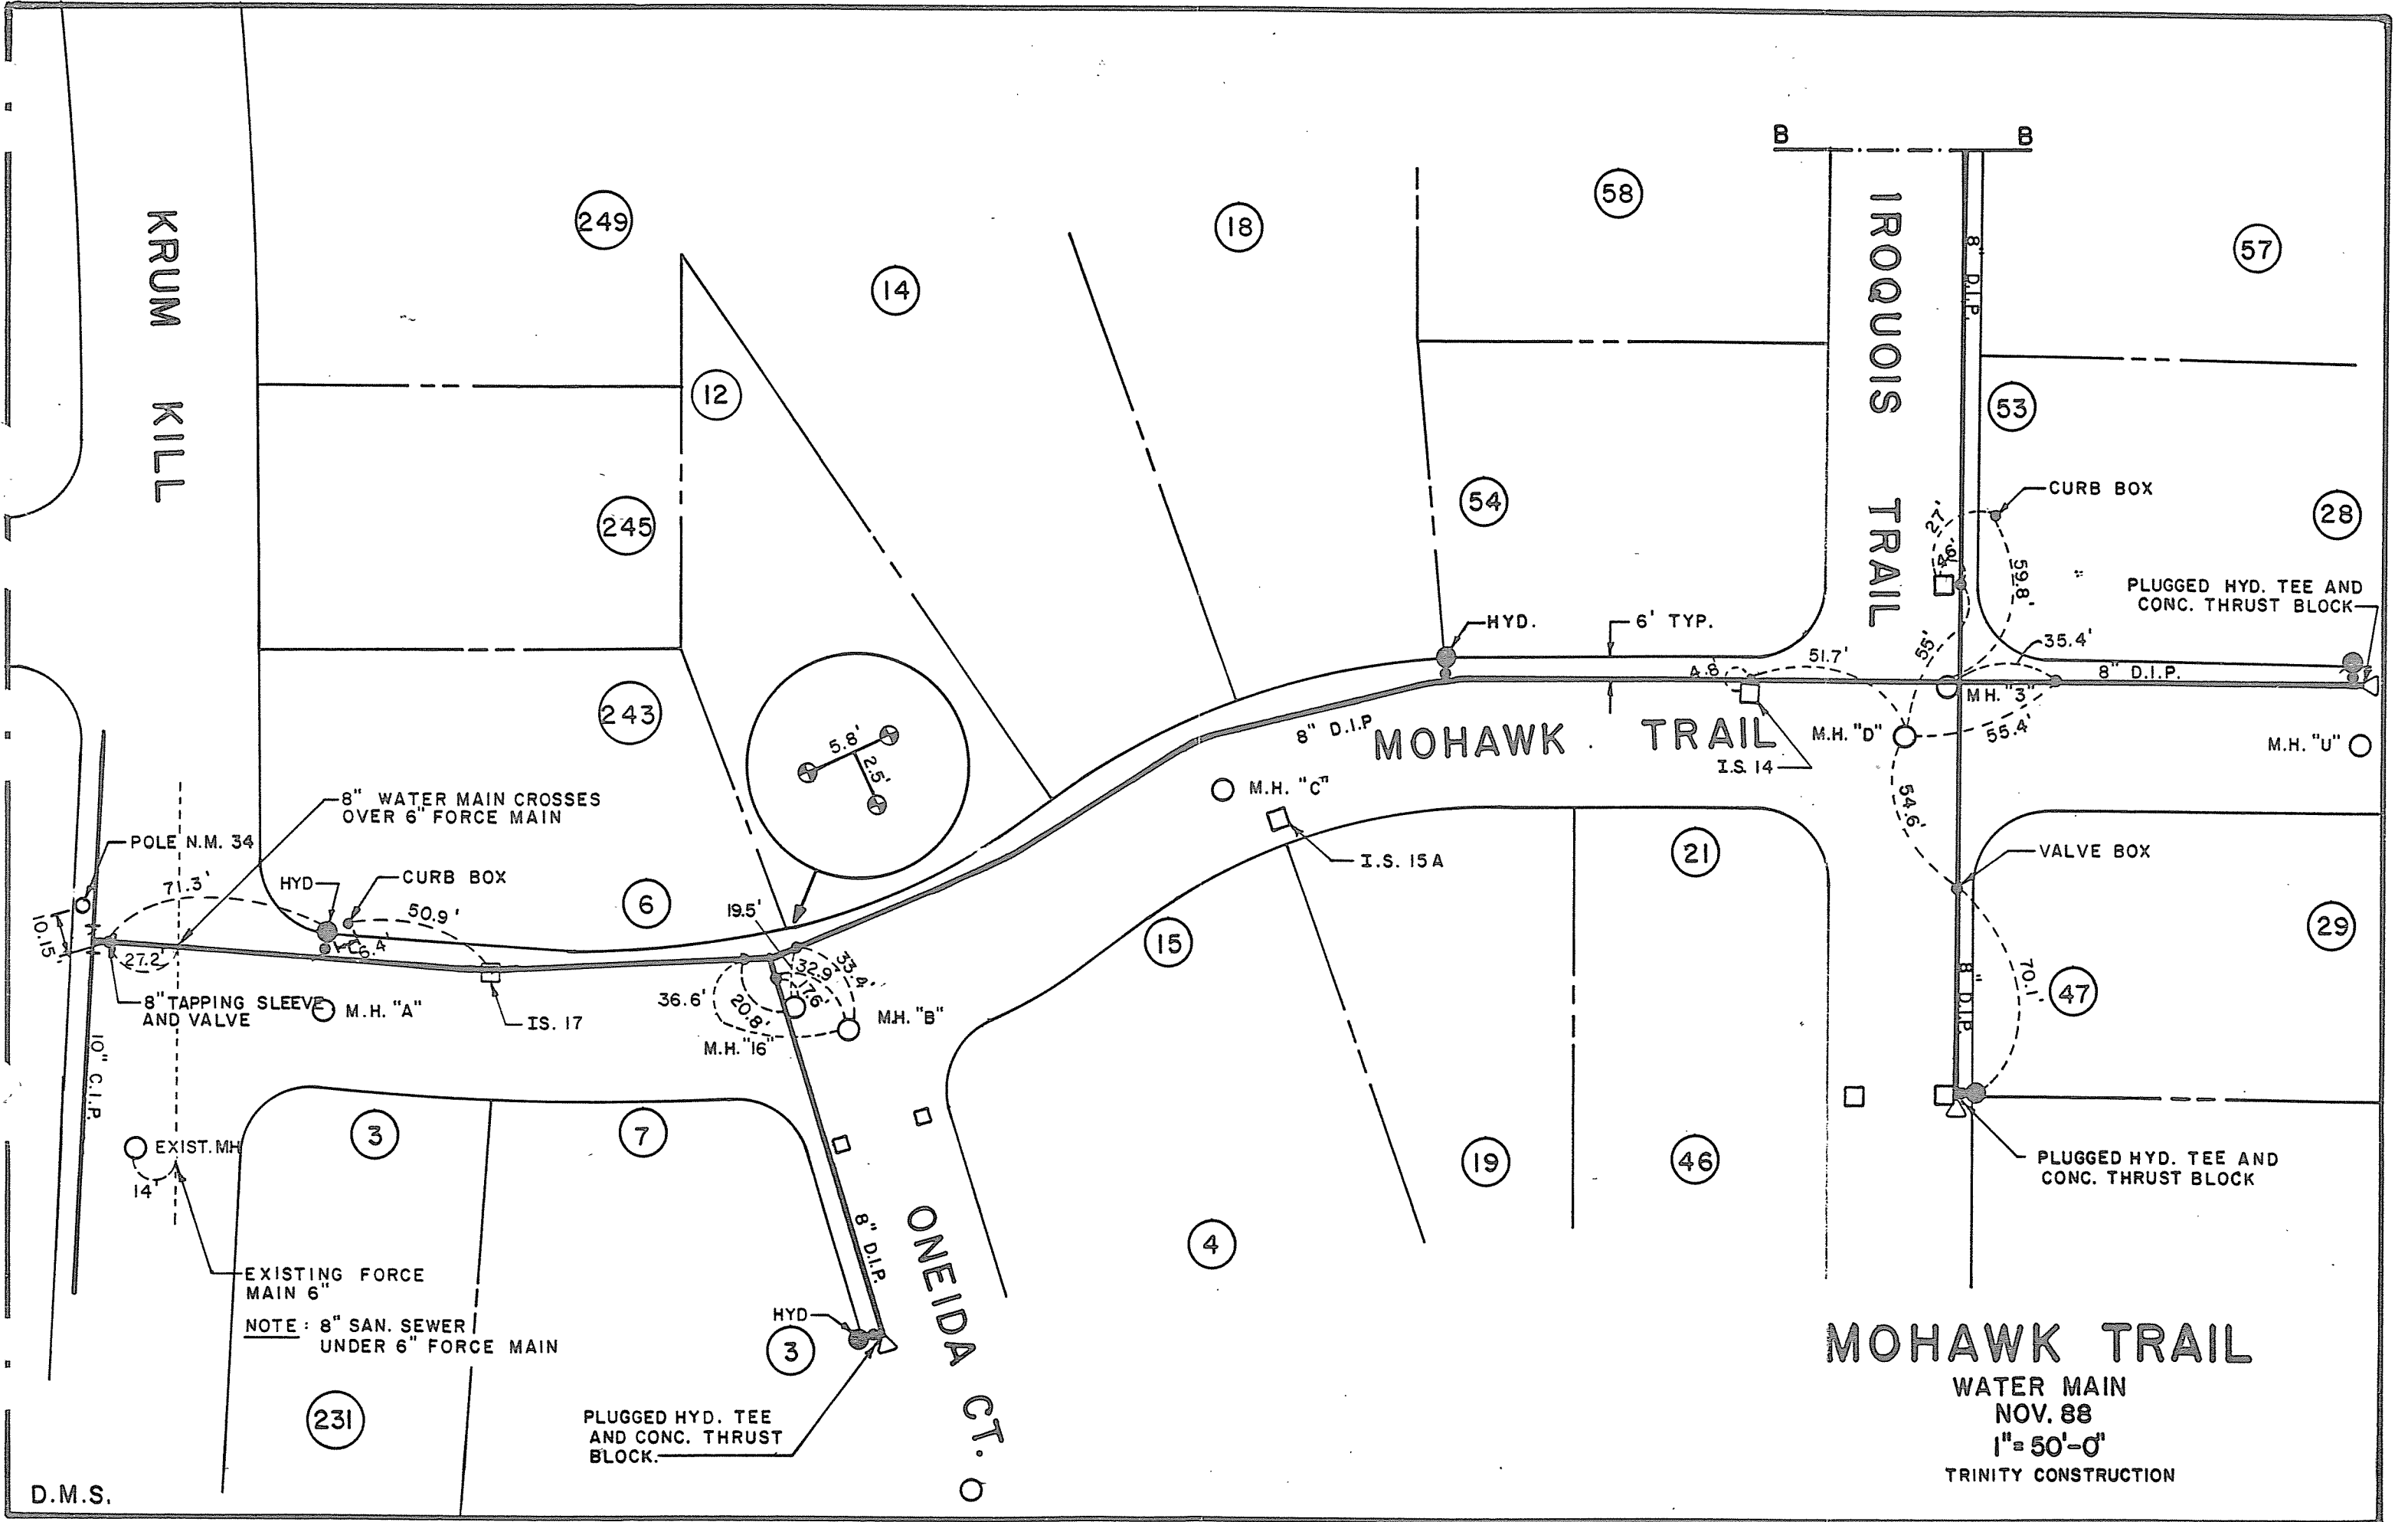

MOHAWK TRAIL
WATER MAIN
NOV. 88
1" = 50'-0"
TRINITY CONSTRUCTION