


- LEGEND**
- CATCH BASIN
 - MANHOLE
 - ⊙ HYDRANT
 - ⊕ GATE VALVE
 - T TEE
 - W— WATER MAIN

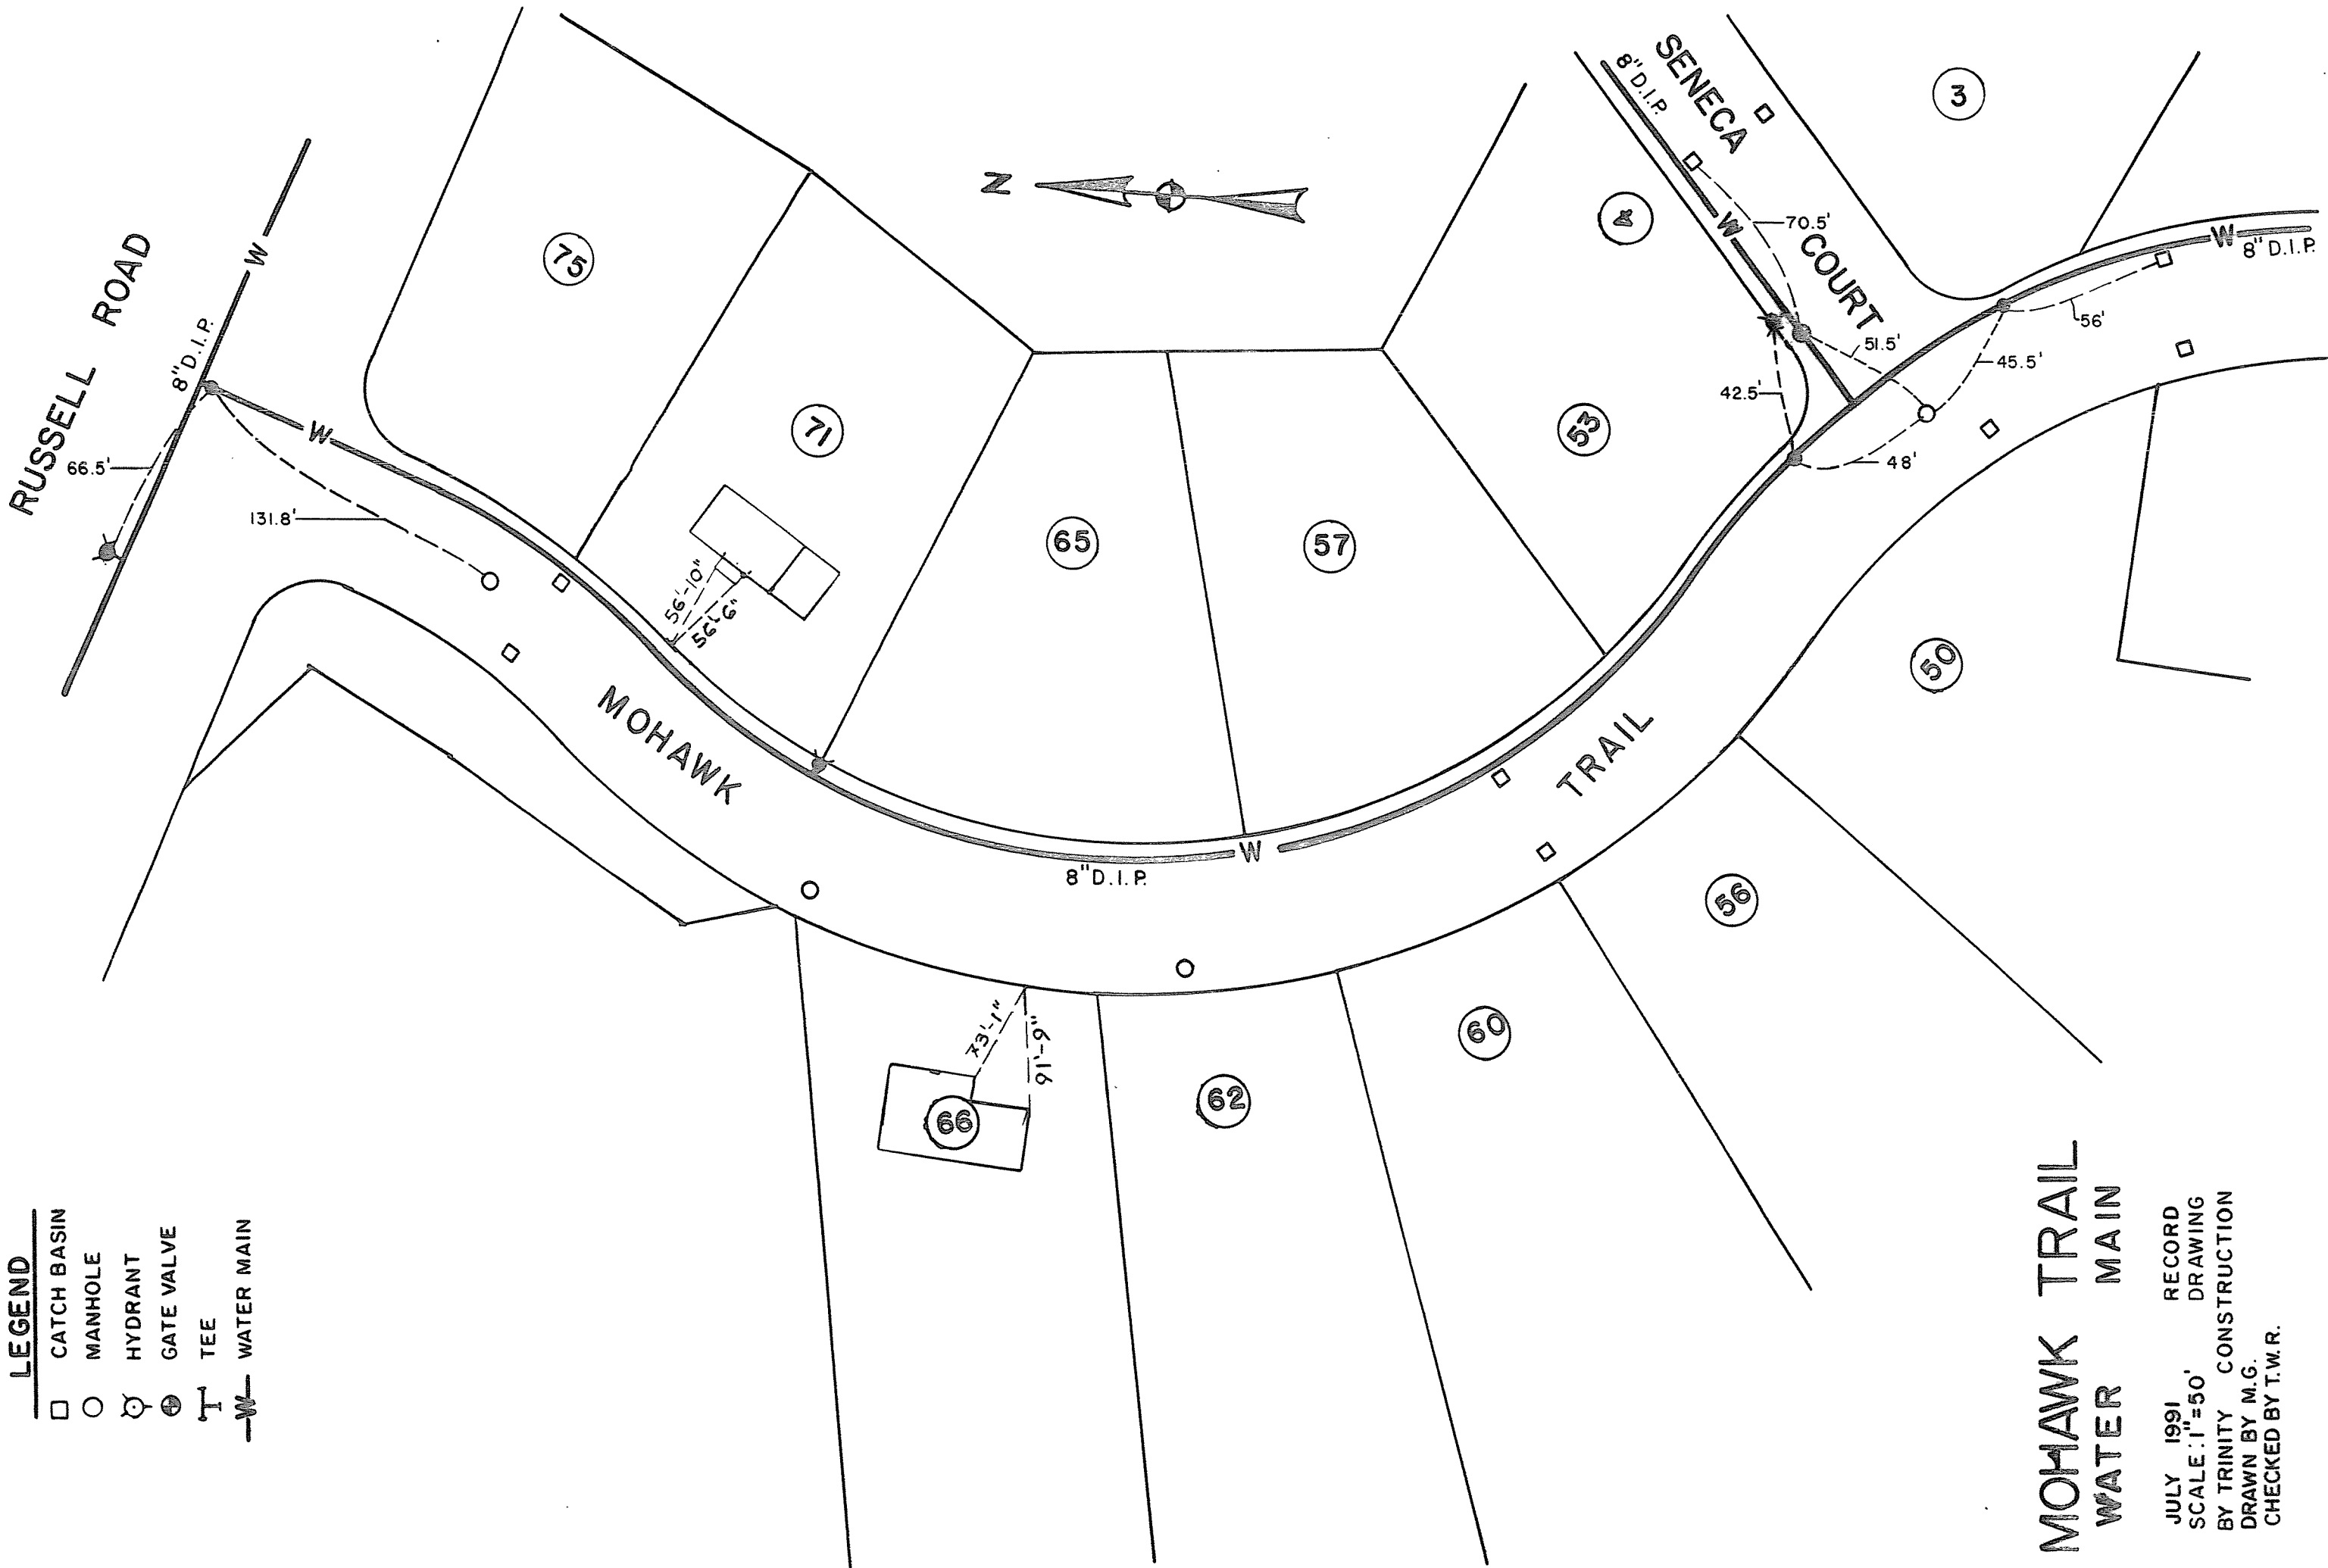

**MOHAWK TRAIL
WATER MAIN**

JULY 1991 RECORD
 SCALE: 1"=50' DRAWING
 BY TRINITY CONSTRUCTION
 DRAWN BY M.G.
 CHECKED BY T.W.R.