


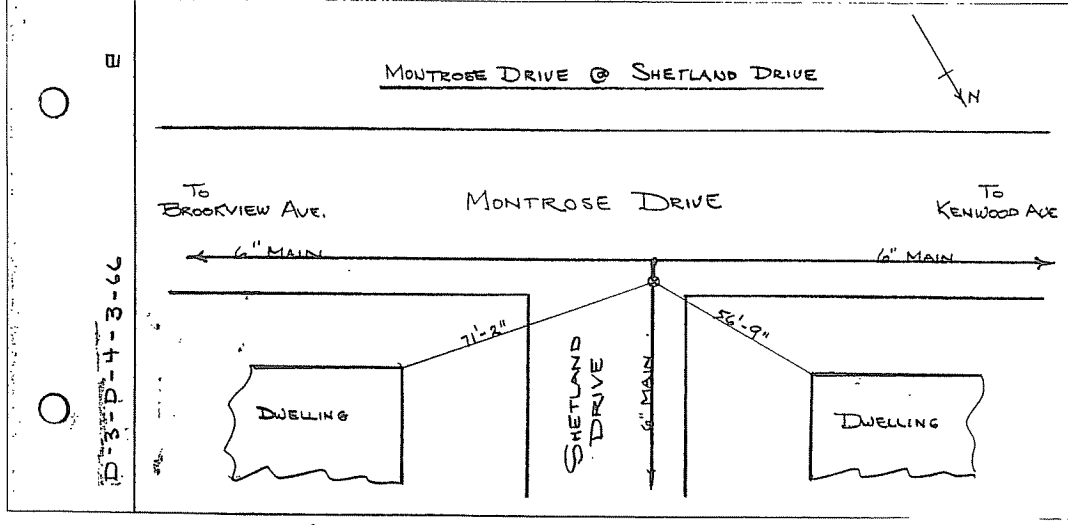

MONTROSE DRIVE
WATER MAIN