


- LEGEND
- CATCH BASIN
 - MANHOLE
 - ⊕ HYDRANT
 - ⊗ GATE VALVE
 - T TEE
 - △ THRUST BLOCK
 - 8" D.I.P. WATER MAIN

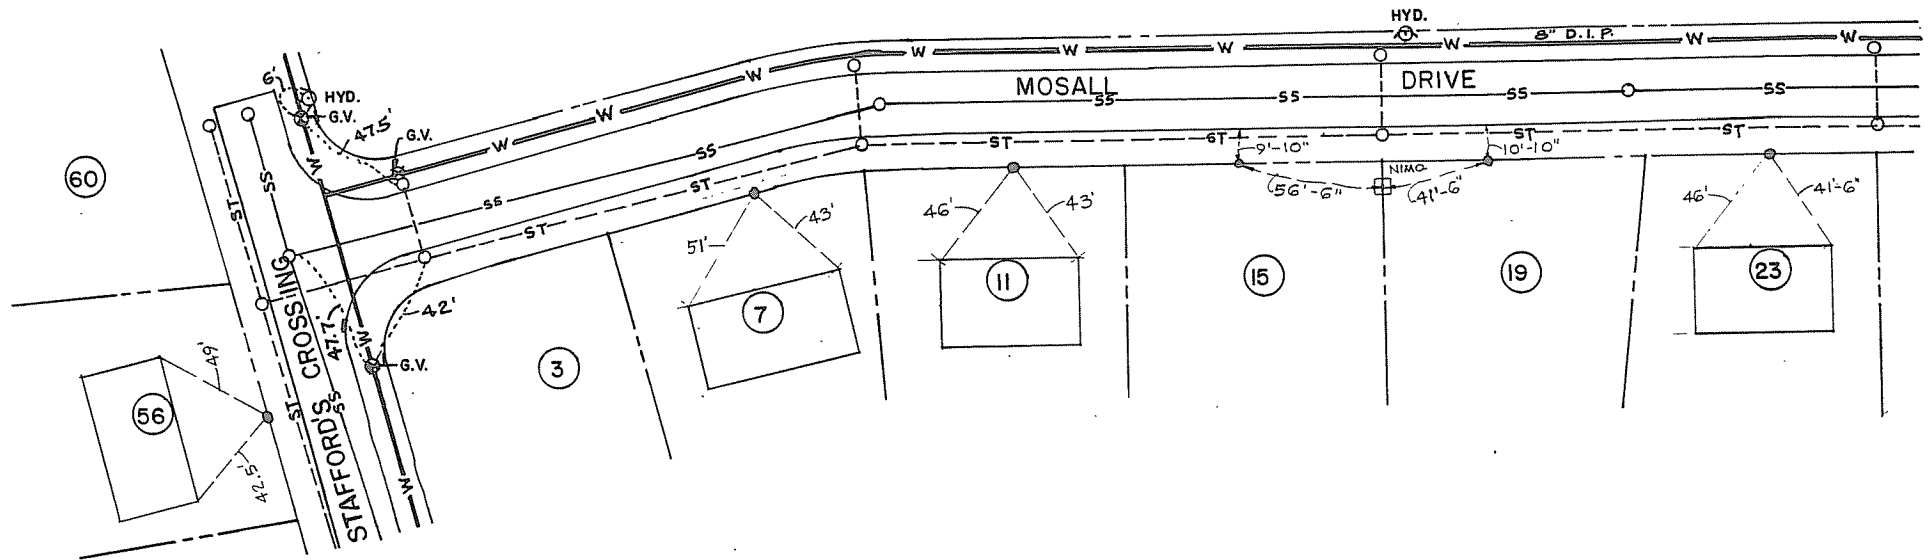

COUNTY ALBANY	MOSALL DRIVE KRUMKILL MANOR EXT 1 WATER MAIN LOCATION	STATE NEW YORK
DATE OCT. 1996		SCALE 1" = 50'
REVISION	 TOWN OF BETHLEHEM ENGINEERING DIVISION 445 Delaware Ave. Delmar, New York 12054	DRAWING NO.