



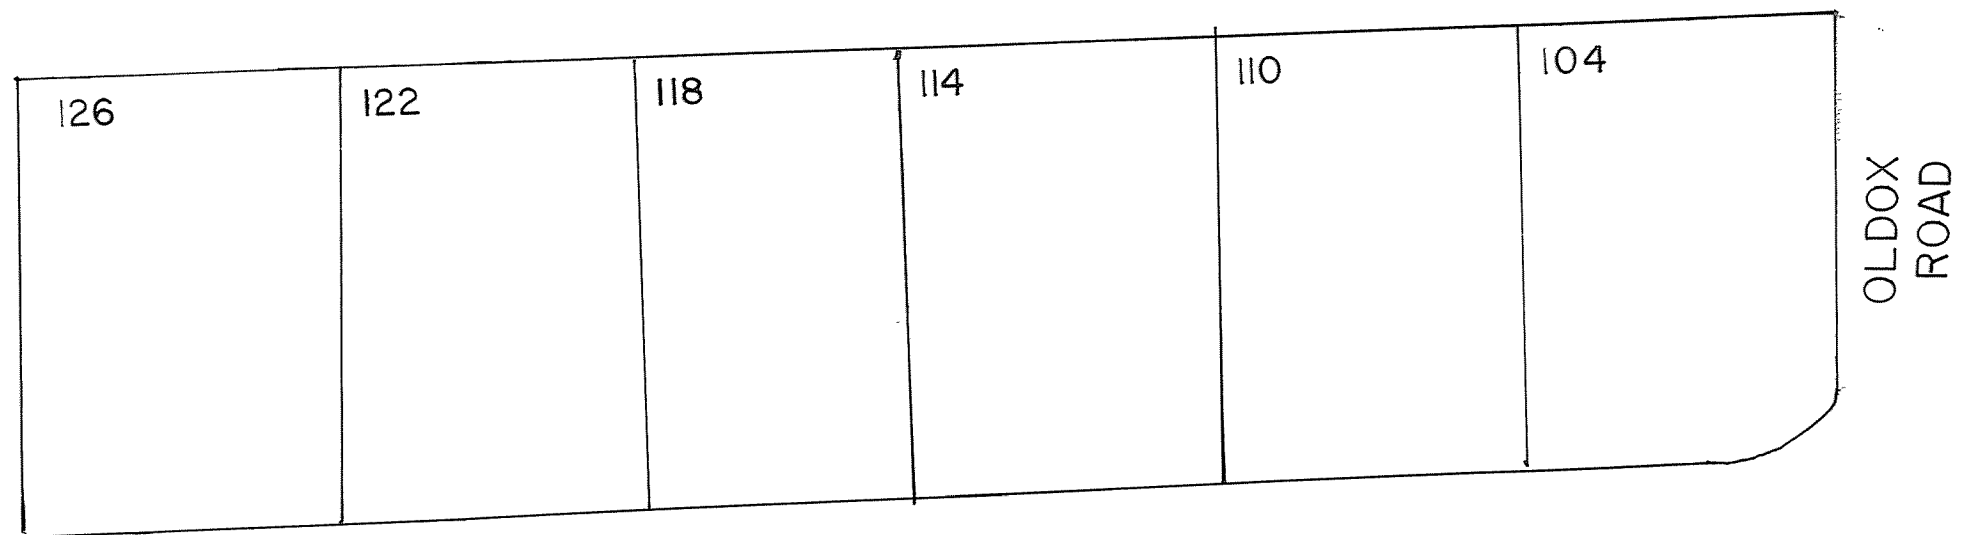


OLDOX
ROAD

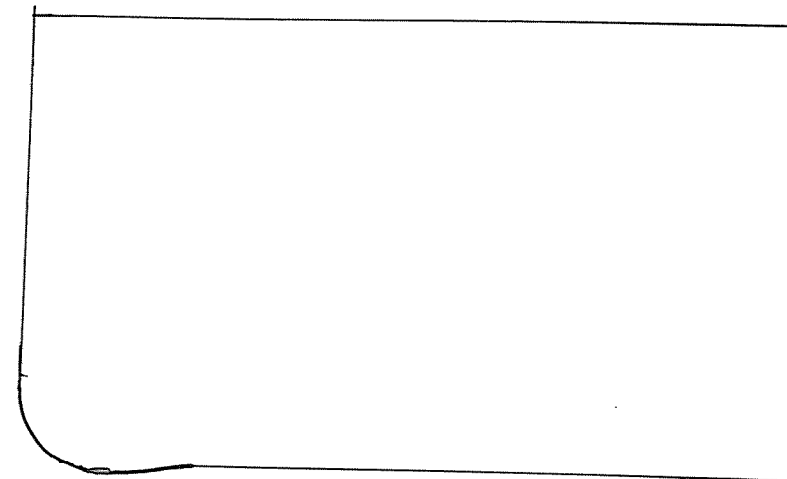


ROAD

MOSHER

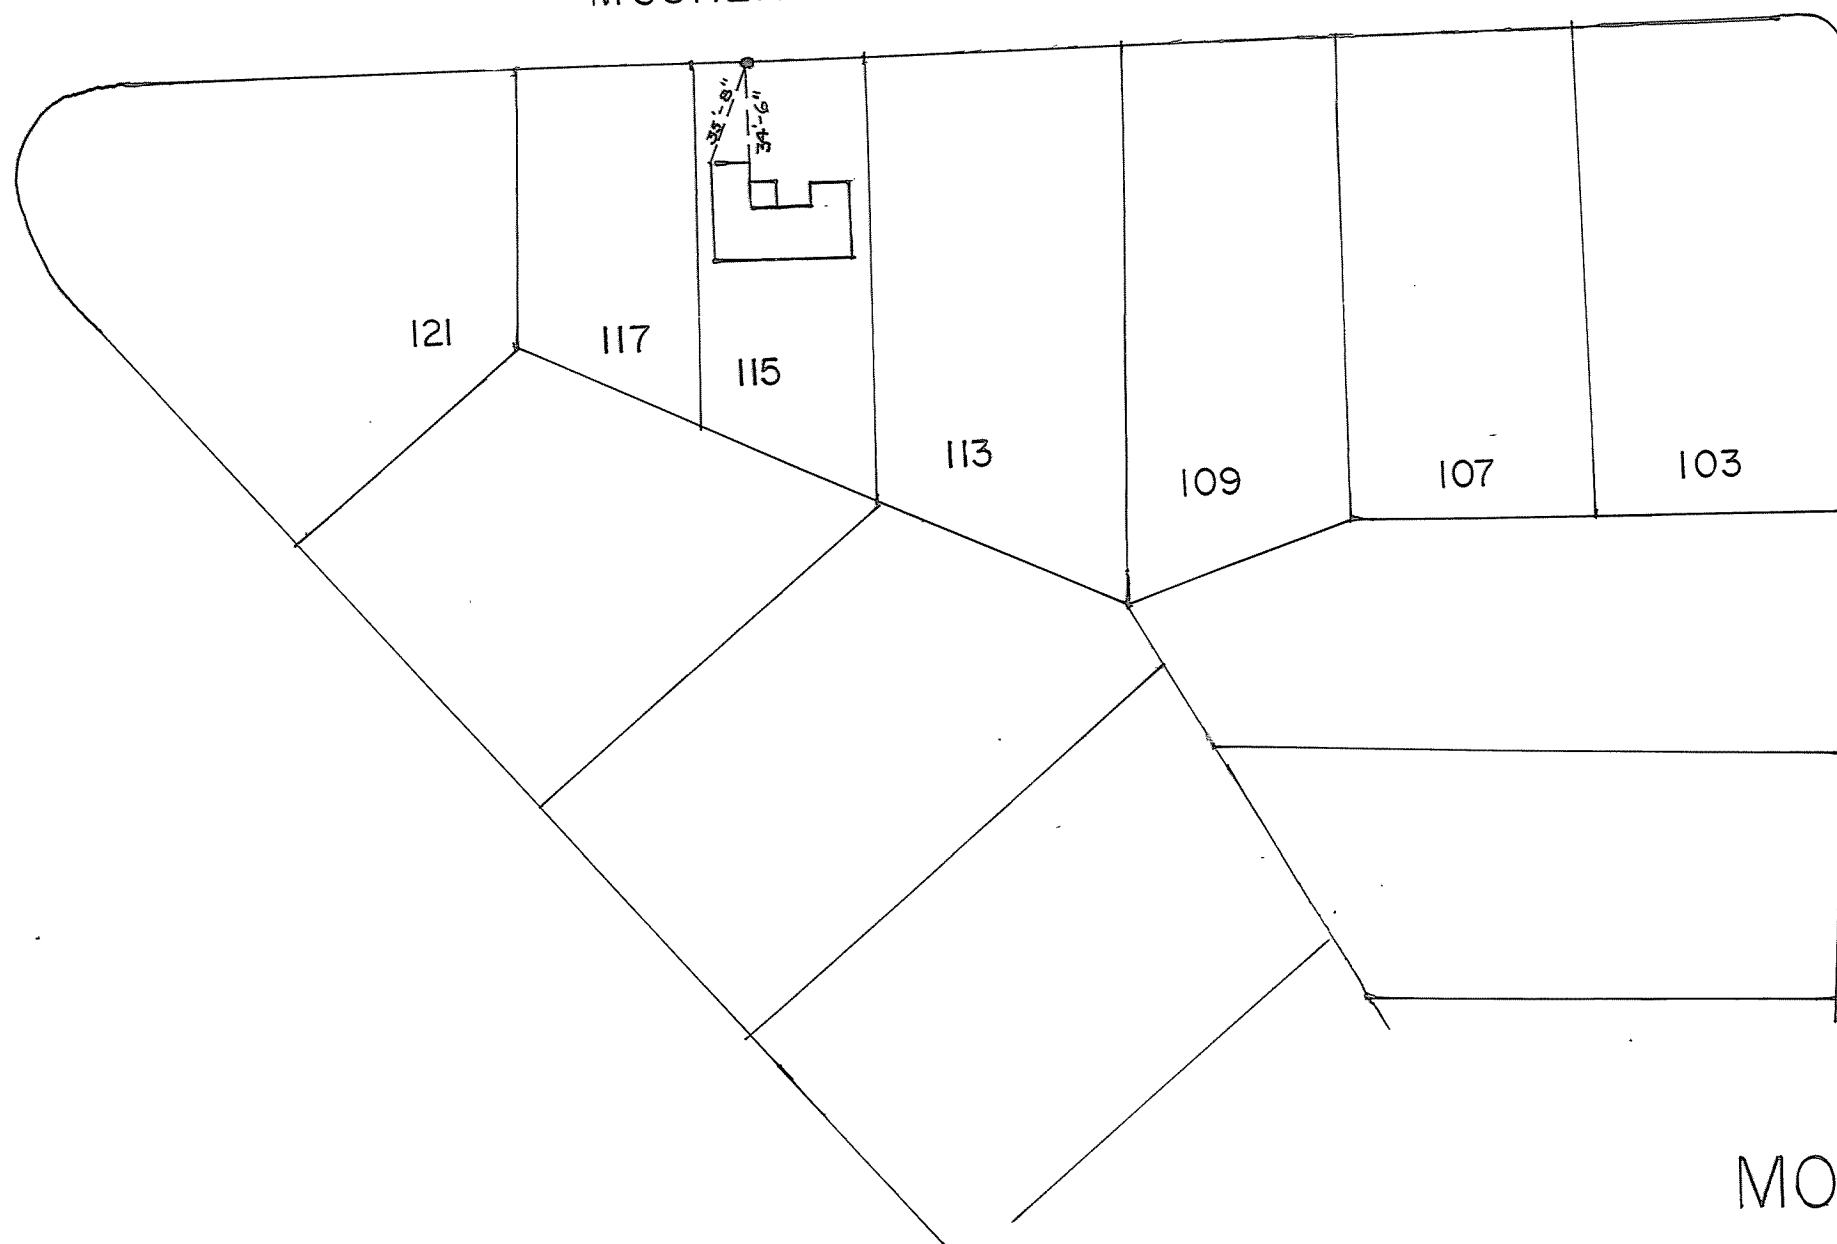

HEATHER
LANE

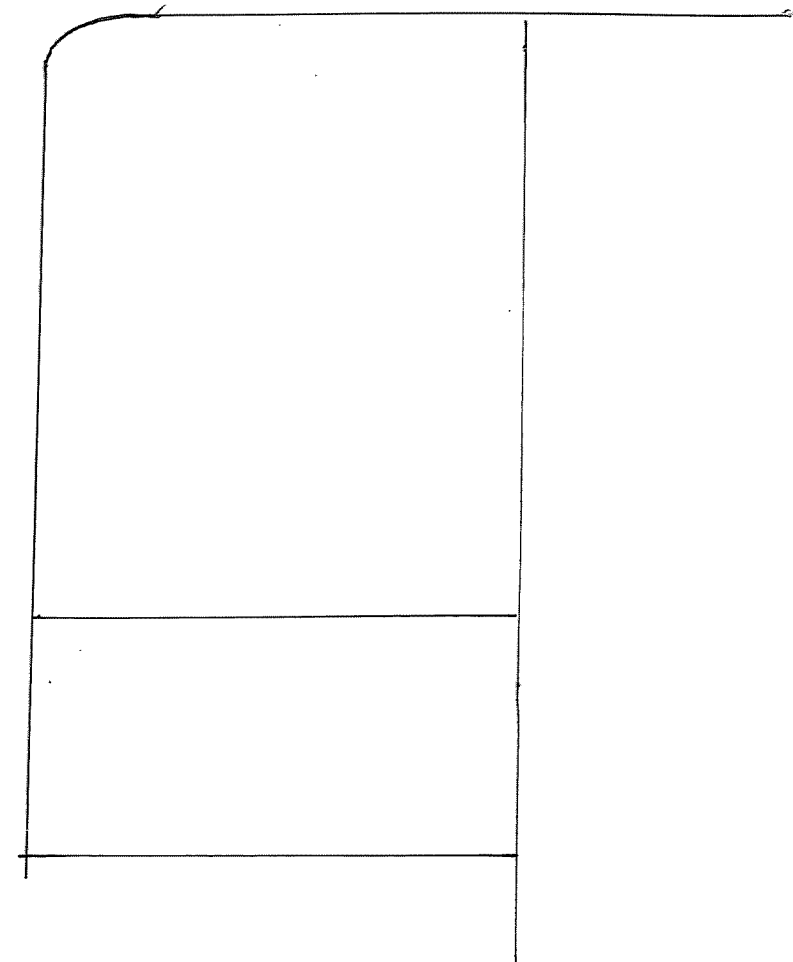

MOSHER ROAD