



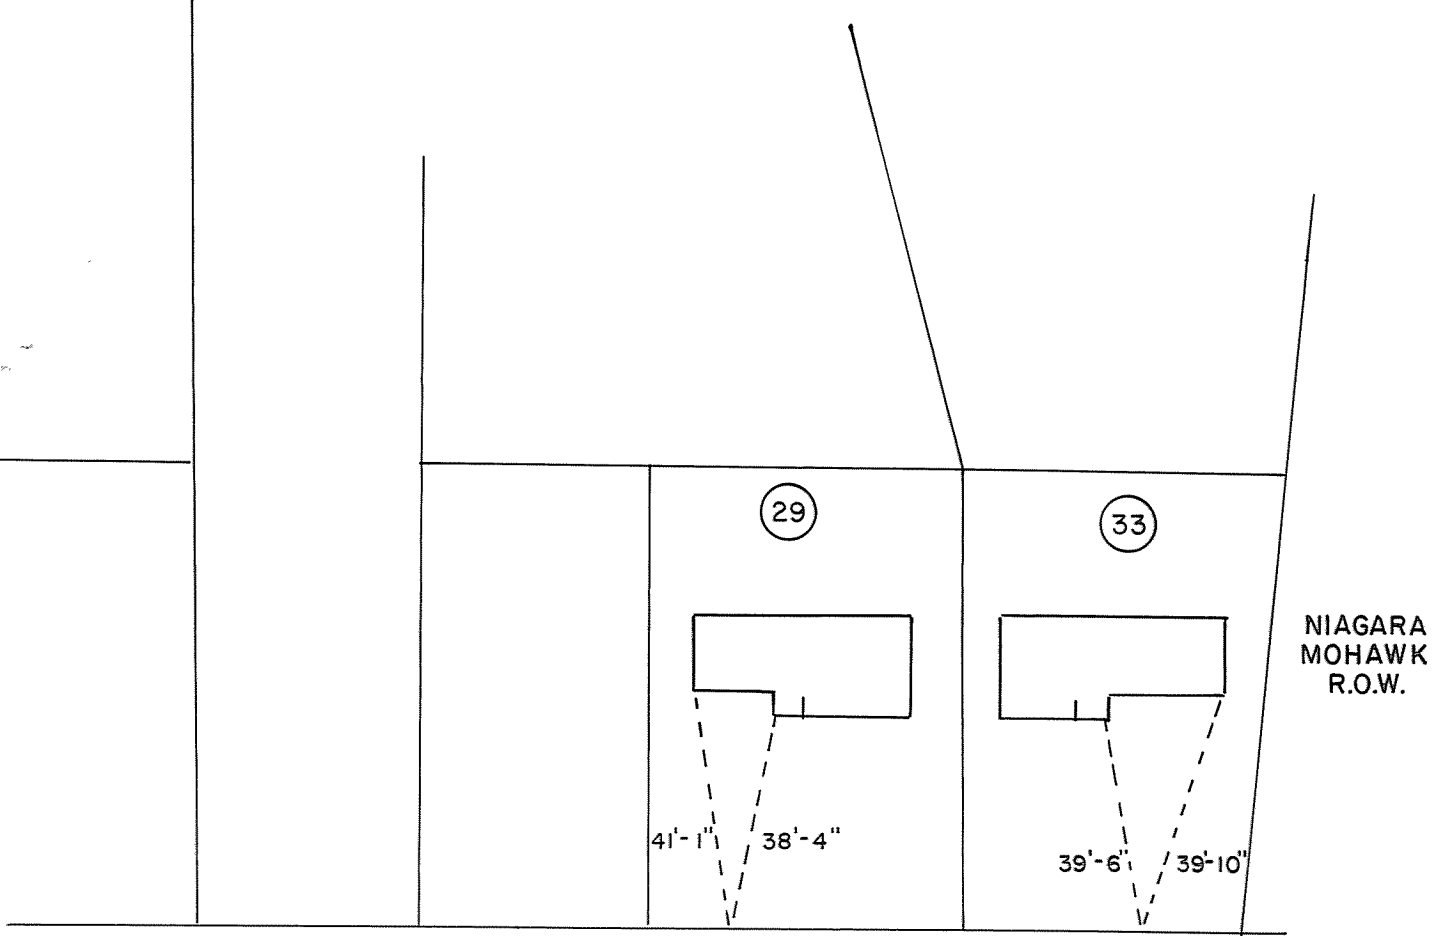

MURRAY DRIVE

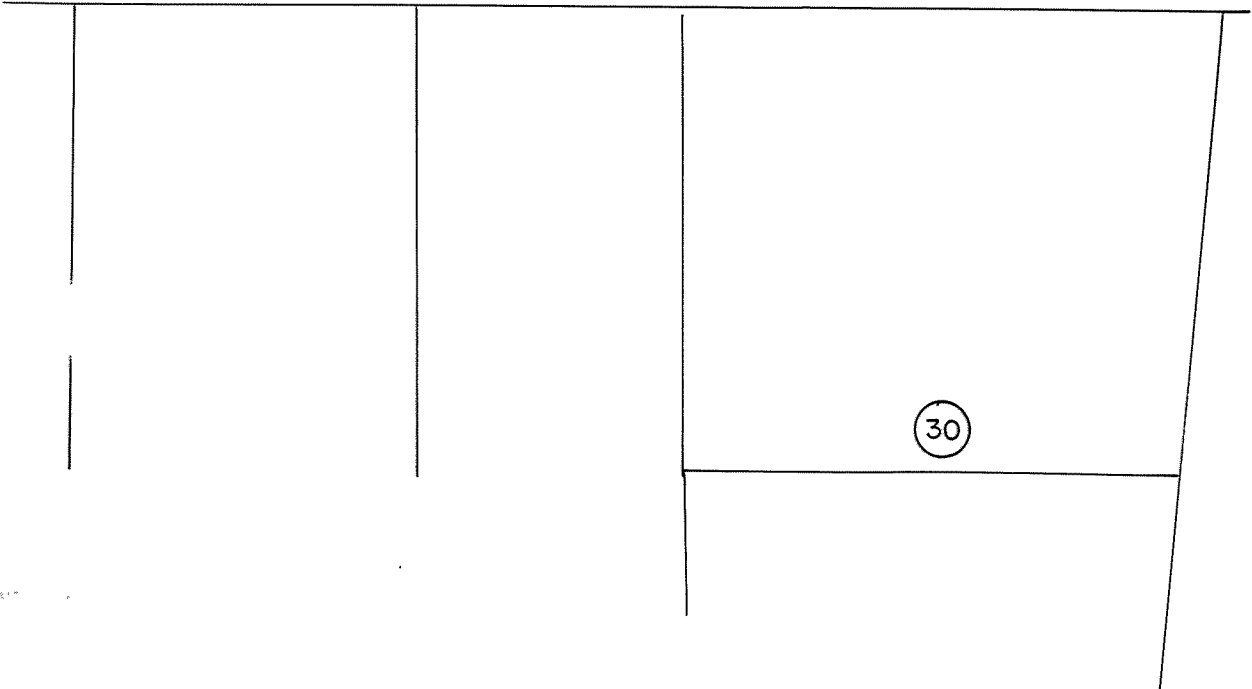

MURRAY DRIVE