


LEGEND

- CATCH BASIN
- MANHOLE
- ⊙ HYDRANT
- ⊕ GATE VALVE
- ⊥ TEE
- ▲ THRUST BLOCK
- W 8" WATER MAIN

NOTE:

ALL WATER MAINS SHALL BE 8" DUCTILE IRON.

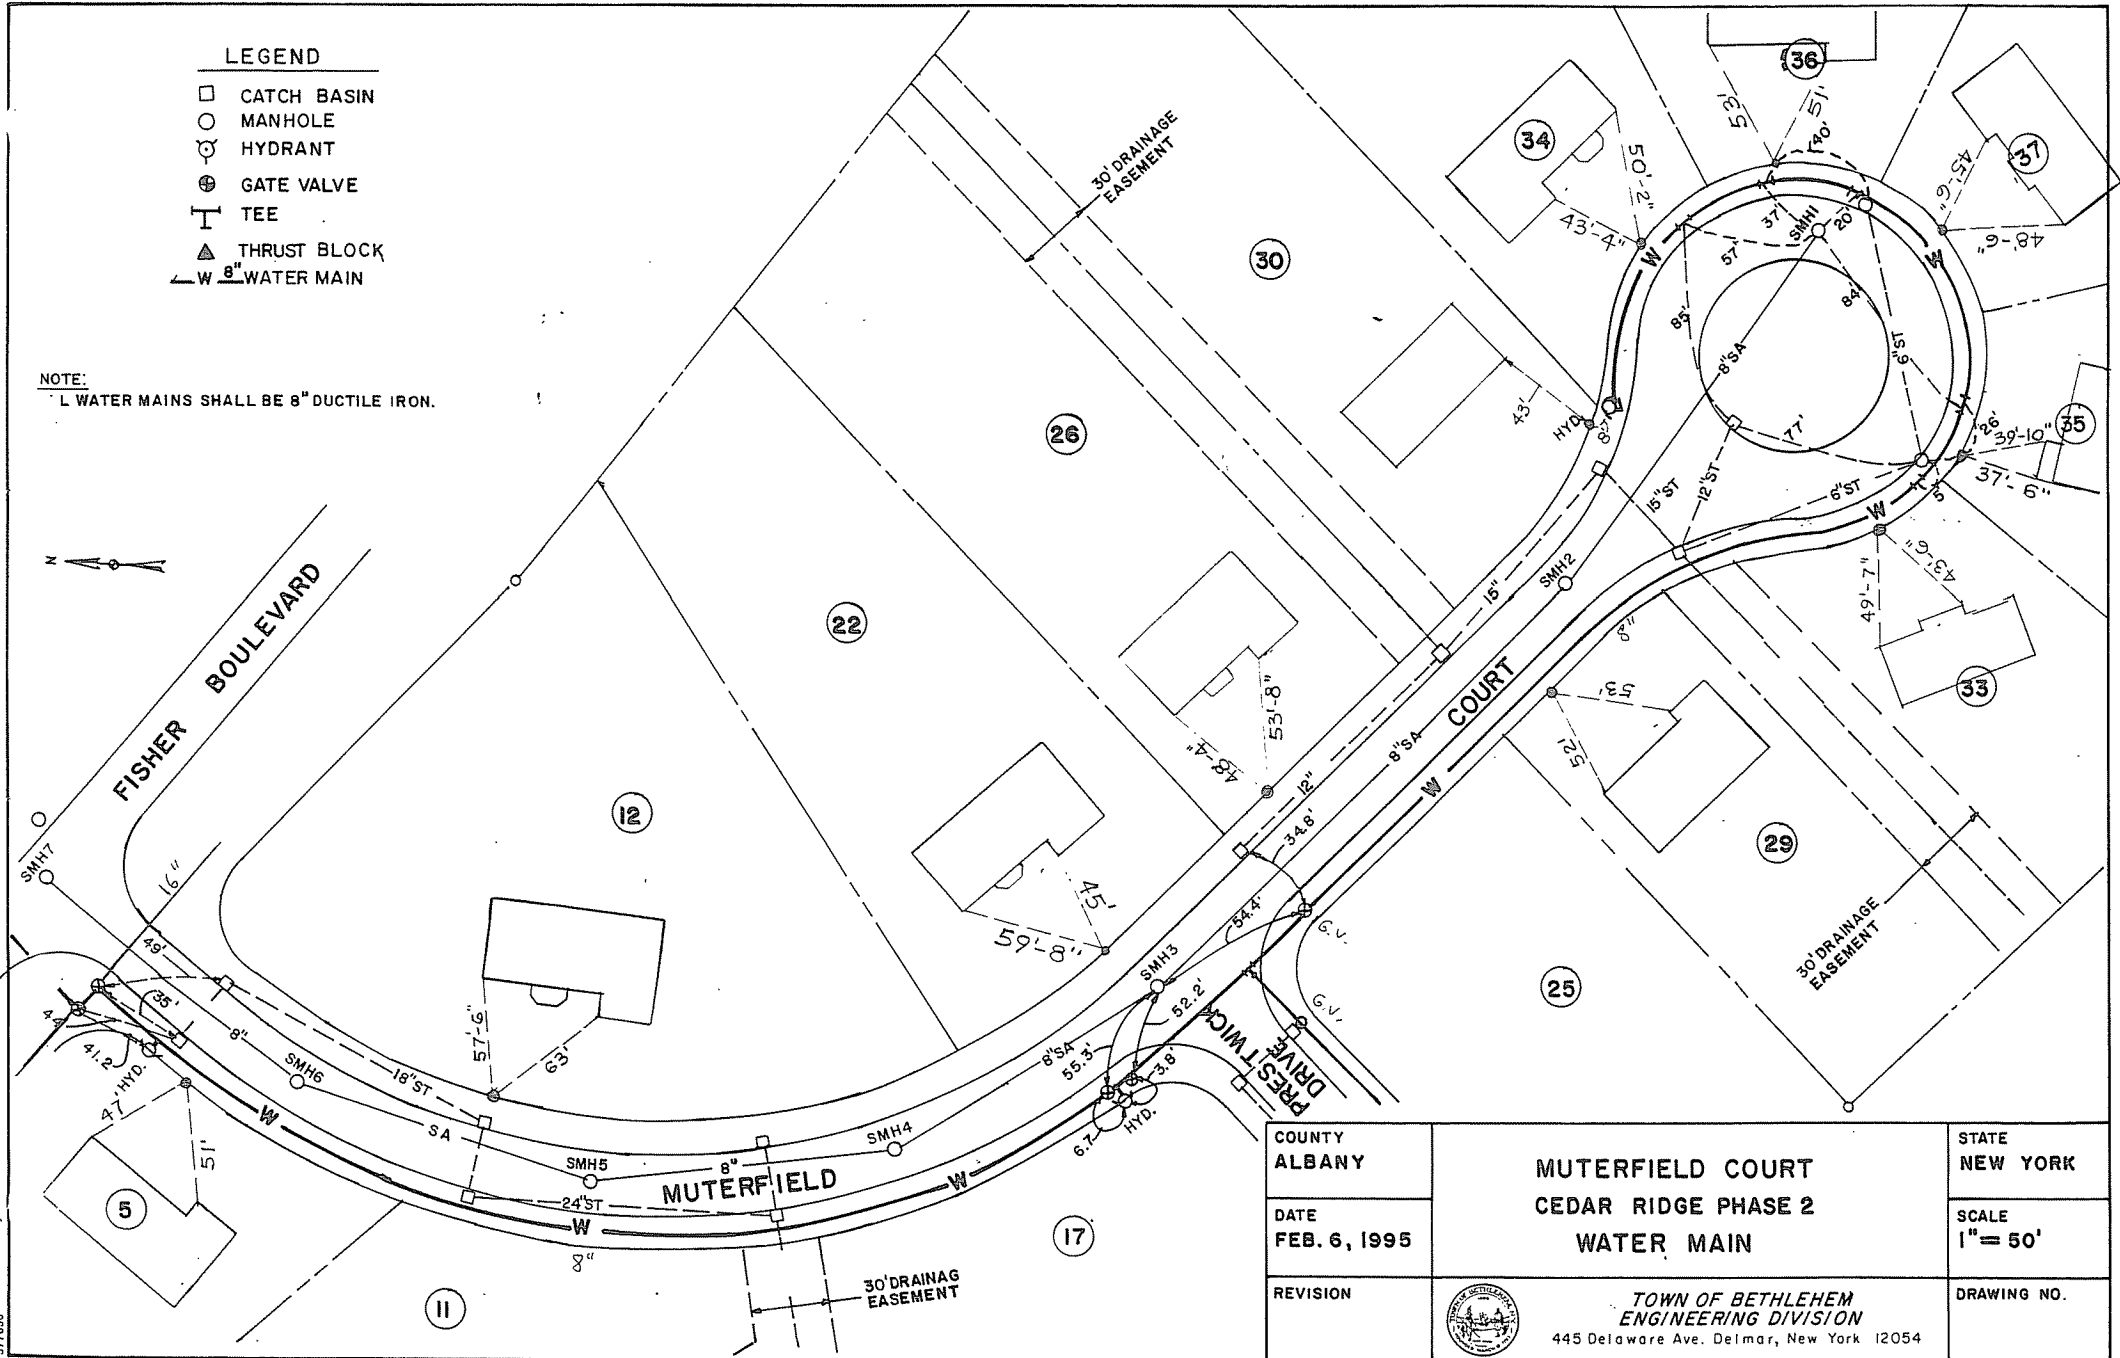

COUNTY
ALBANY

DATE
FEB. 6, 1995

REVISION

MUTERFIELD COURT
CEDAR RIDGE PHASE 2
WATER MAIN



TOWN OF BETHLEHEM
ENGINEERING DIVISION
445 Delaware Ave. Delmar, New York 12054

STATE
NEW YORK

SCALE
1" = 50'

DRAWING NO.