


LEGEND

- CATCH BASIN
- MANHOLE
- ⊙ HYDRANT
- ⊕ GATE VALVE
- T TEE
- ▲ TRUSS BLOCK
- W 8" WATER MAIN

NOTE:
ALL WATER MAINS SHALL BE 8" DUCTILE IRON.

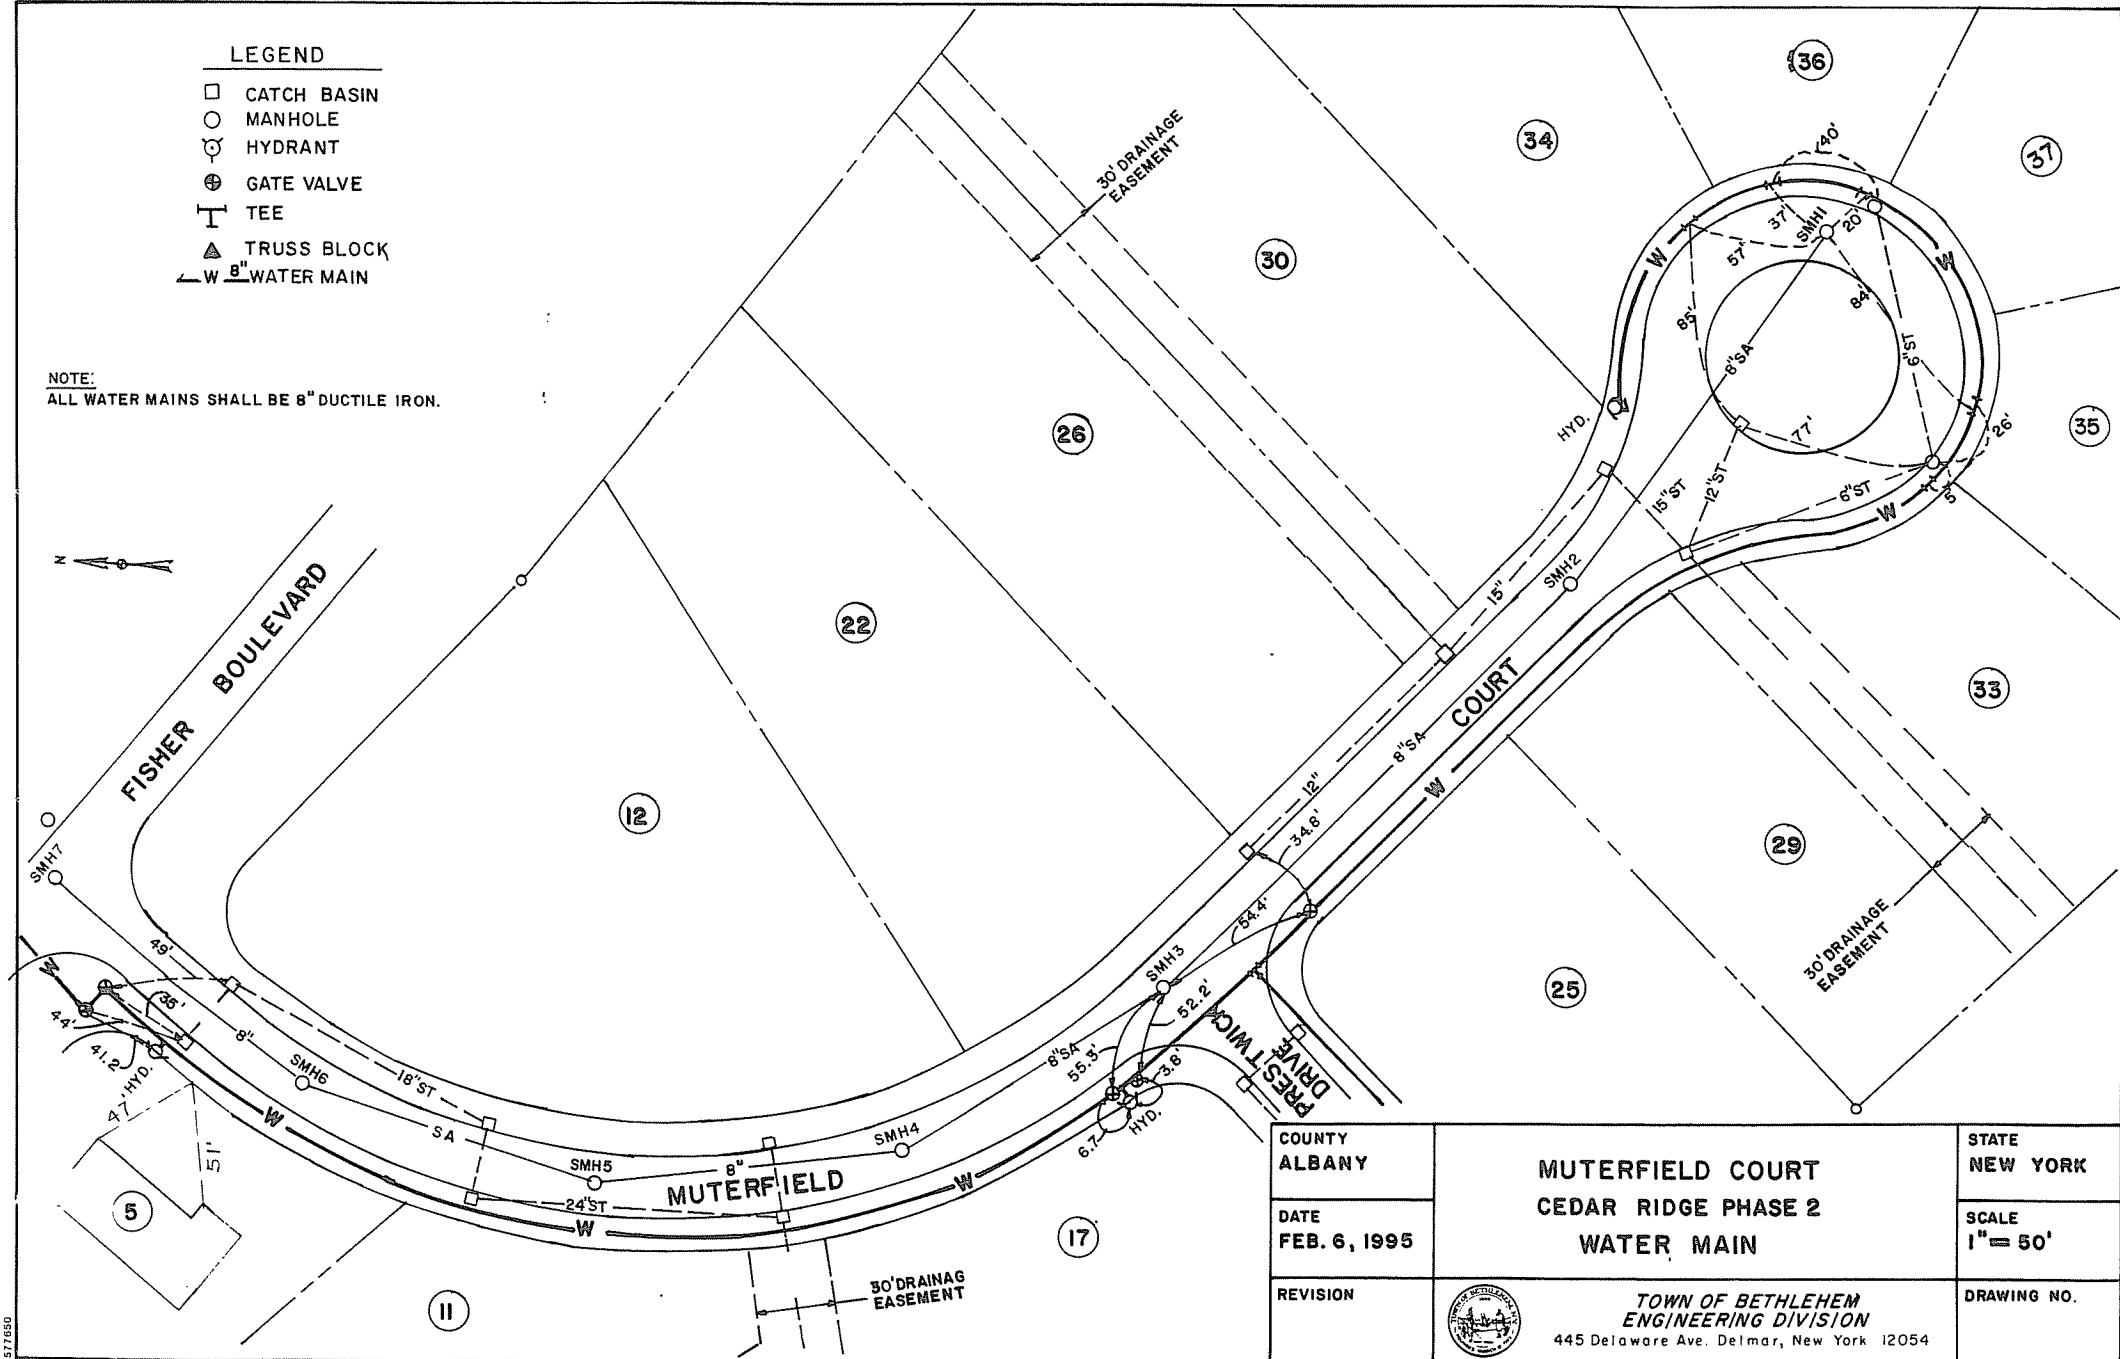

COUNTY ALBANY	MUTERFIELD COURT CEDAR RIDGE PHASE 2 WATER MAIN	STATE NEW YORK
DATE FEB. 6, 1995		SCALE 1" = 50'
REVISION	 TOWN OF BETHLEHEM ENGINEERING DIVISION 445 Delaware Ave. Delmar, New York 12054	DRAWING NO.