


N
1

NATHANIEL BOULEVARD
WATER DISTRICT NO. 1
TOWN OF BETHLEHEM
RECORD OF INSTALLATION
TOWN OF BETHLEHEM ENGINEERING
DEPARTMENT

SCALE: 1"=50' FEBRUARY, 1982
DWN. BY: PDH

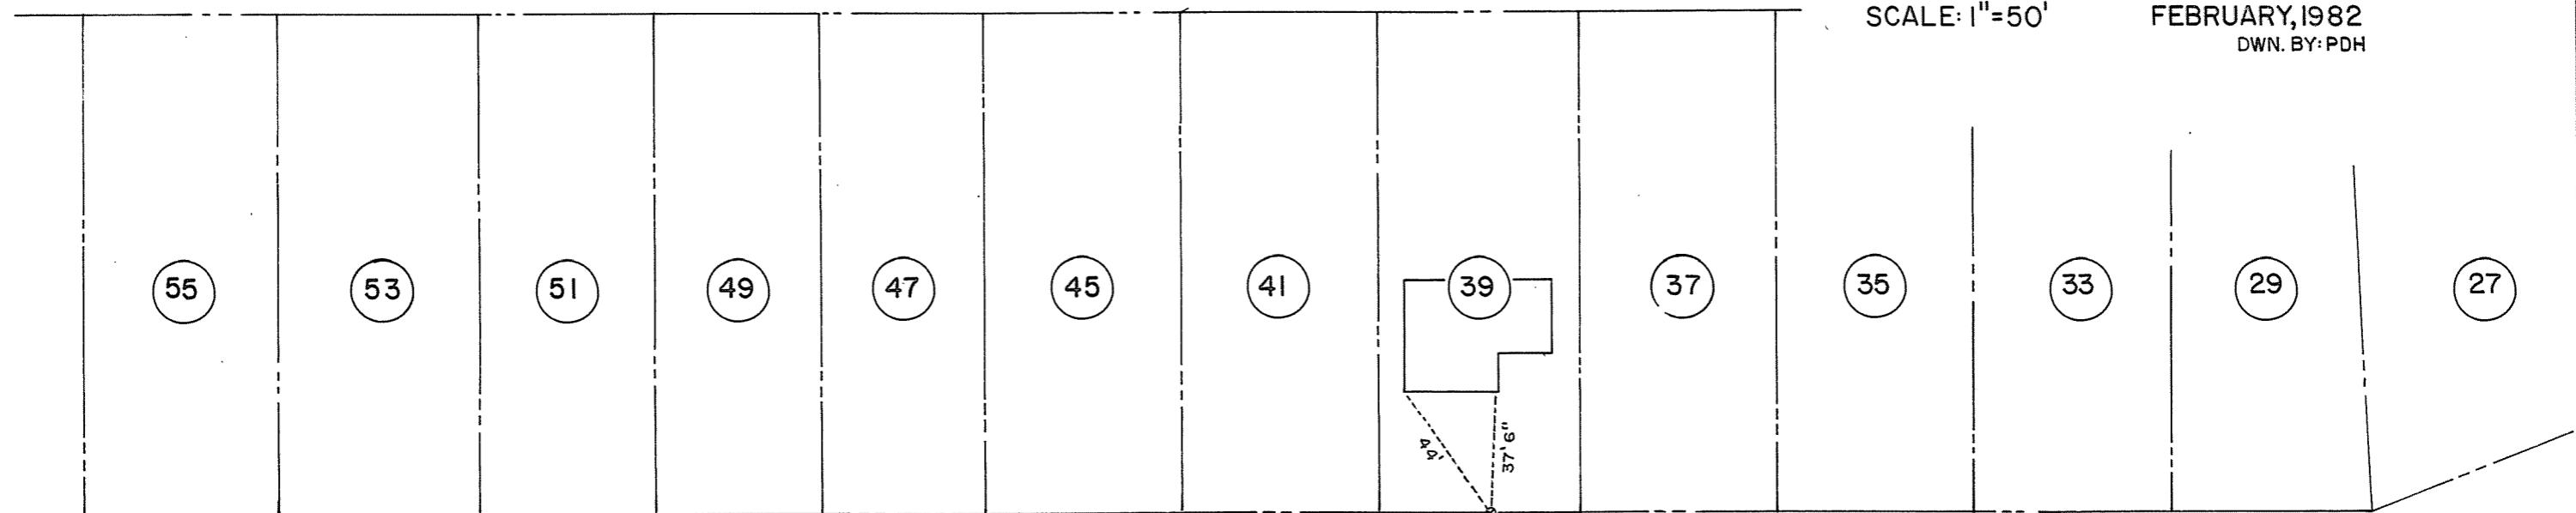

NATHANIEL

BOULEVARD

DYER TERRACE

