



NEW SCOTLAND ROAD

NEW SCOTLAND ROAD

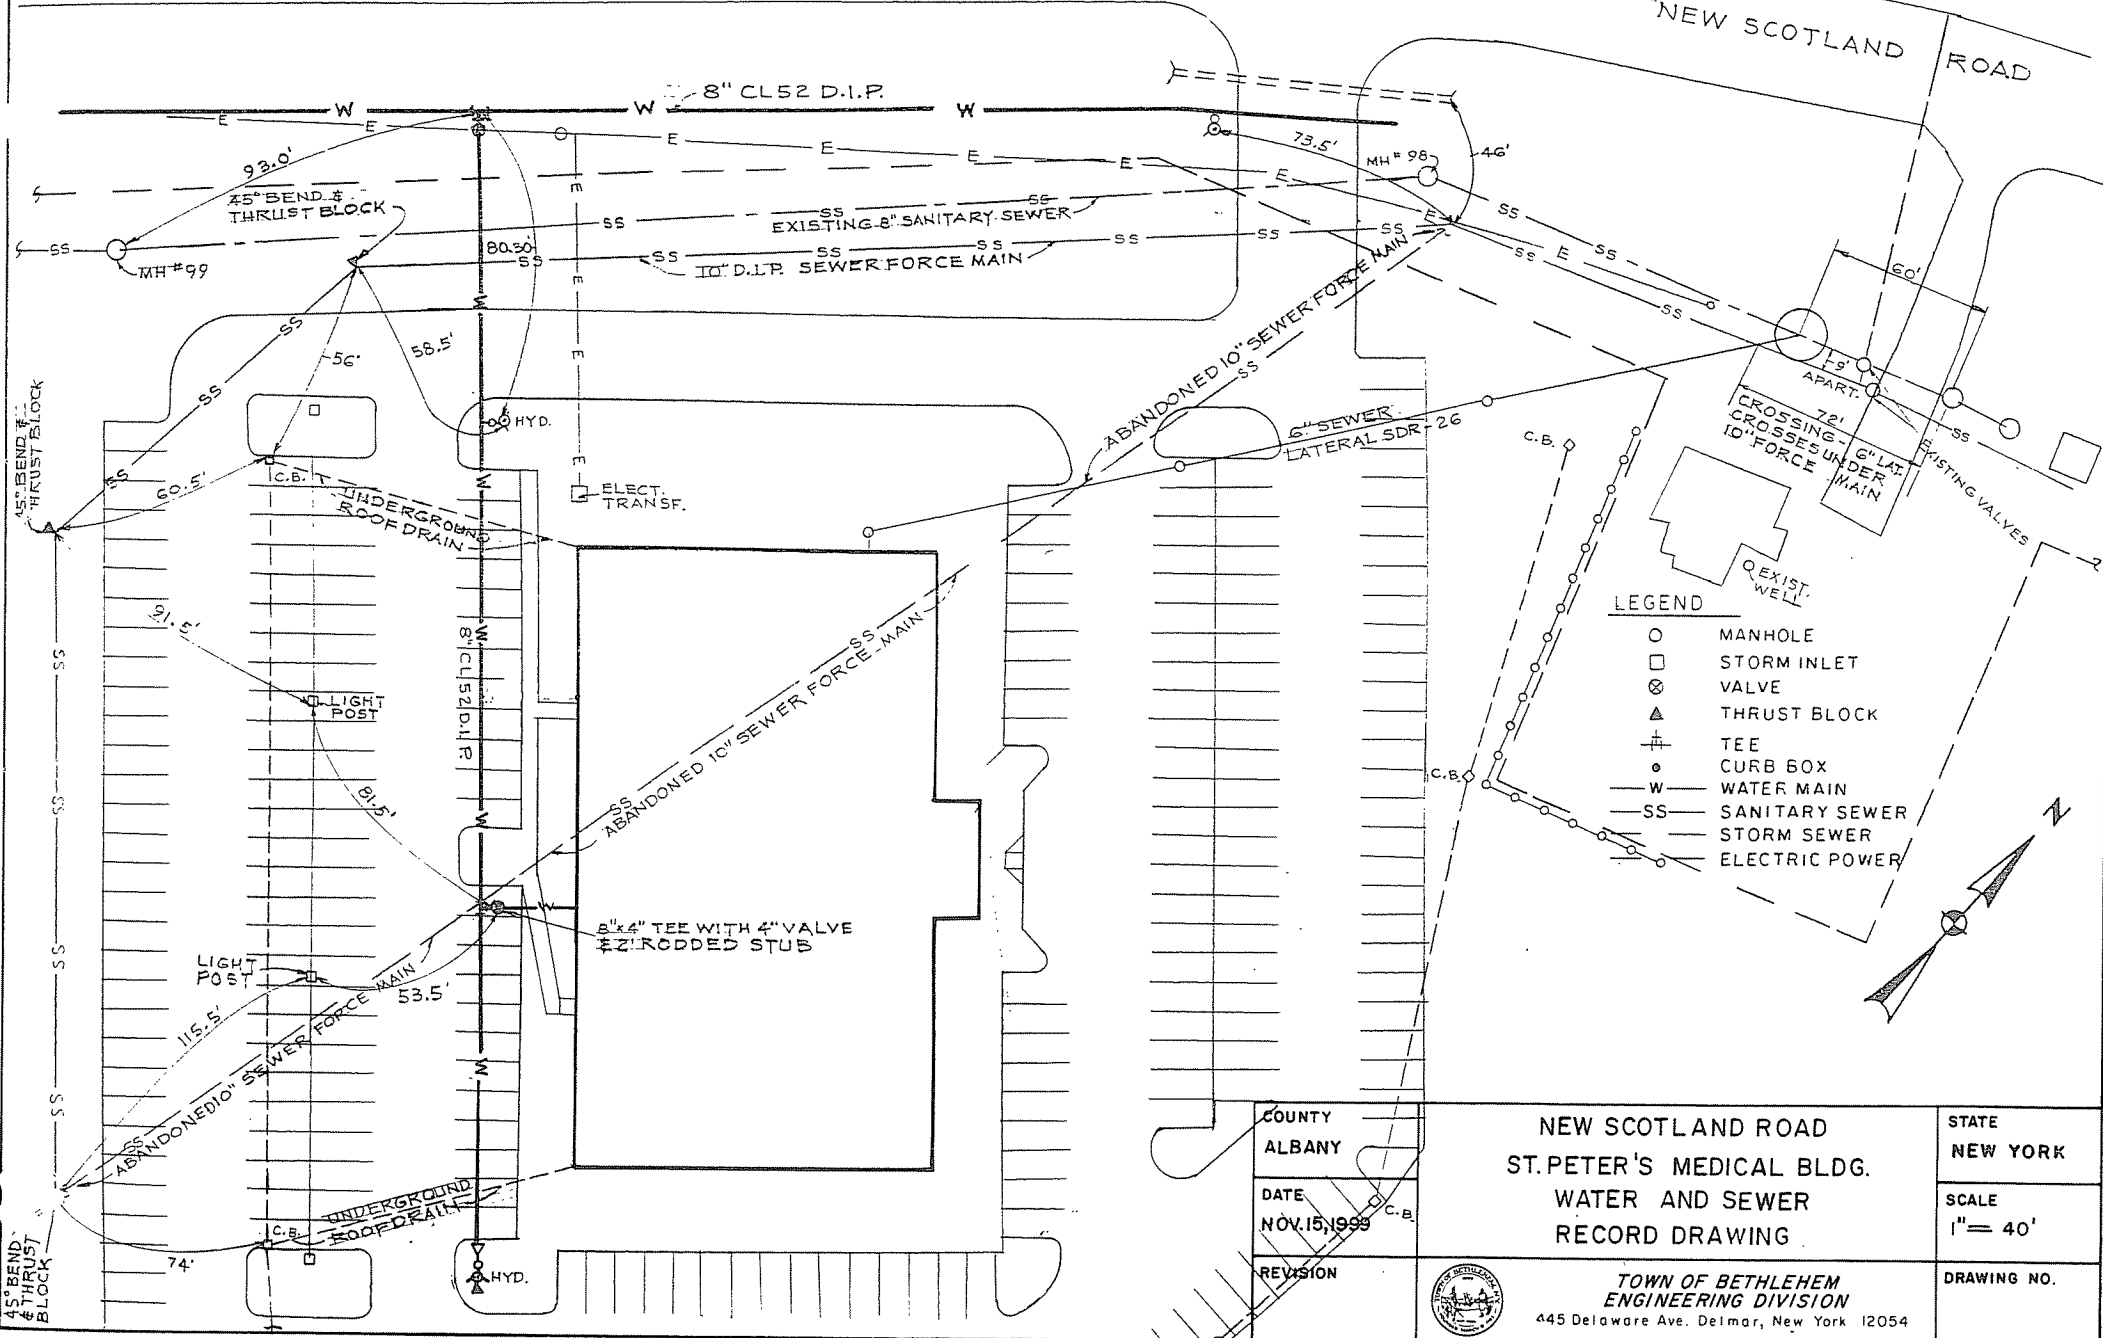

- LEGEND
- MANHOLE
 - STORM INLET
 - ⊗ VALVE
 - ▲ THRUST BLOCK
 - ⊥ TEE
 - CURB BOX
 - WATER MAIN
 - SS SANITARY SEWER
 - STORM SEWER
 - ELECTRIC POWER

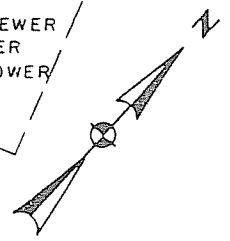

COUNTY ALBANY	NEW SCOTLAND ROAD ST. PETER'S MEDICAL BLDG. WATER AND SEWER RECORD DRAWING	STATE NEW YORK
DATE NOV. 15, 1993		SCALE 1" = 40'
REVISION	TOWN OF BETHLEHEM ENGINEERING DIVISION 445 Delaware Ave. Delmar, New York 12054	DRAWING NO.



577650