


SOUTHWOOD DRIVE

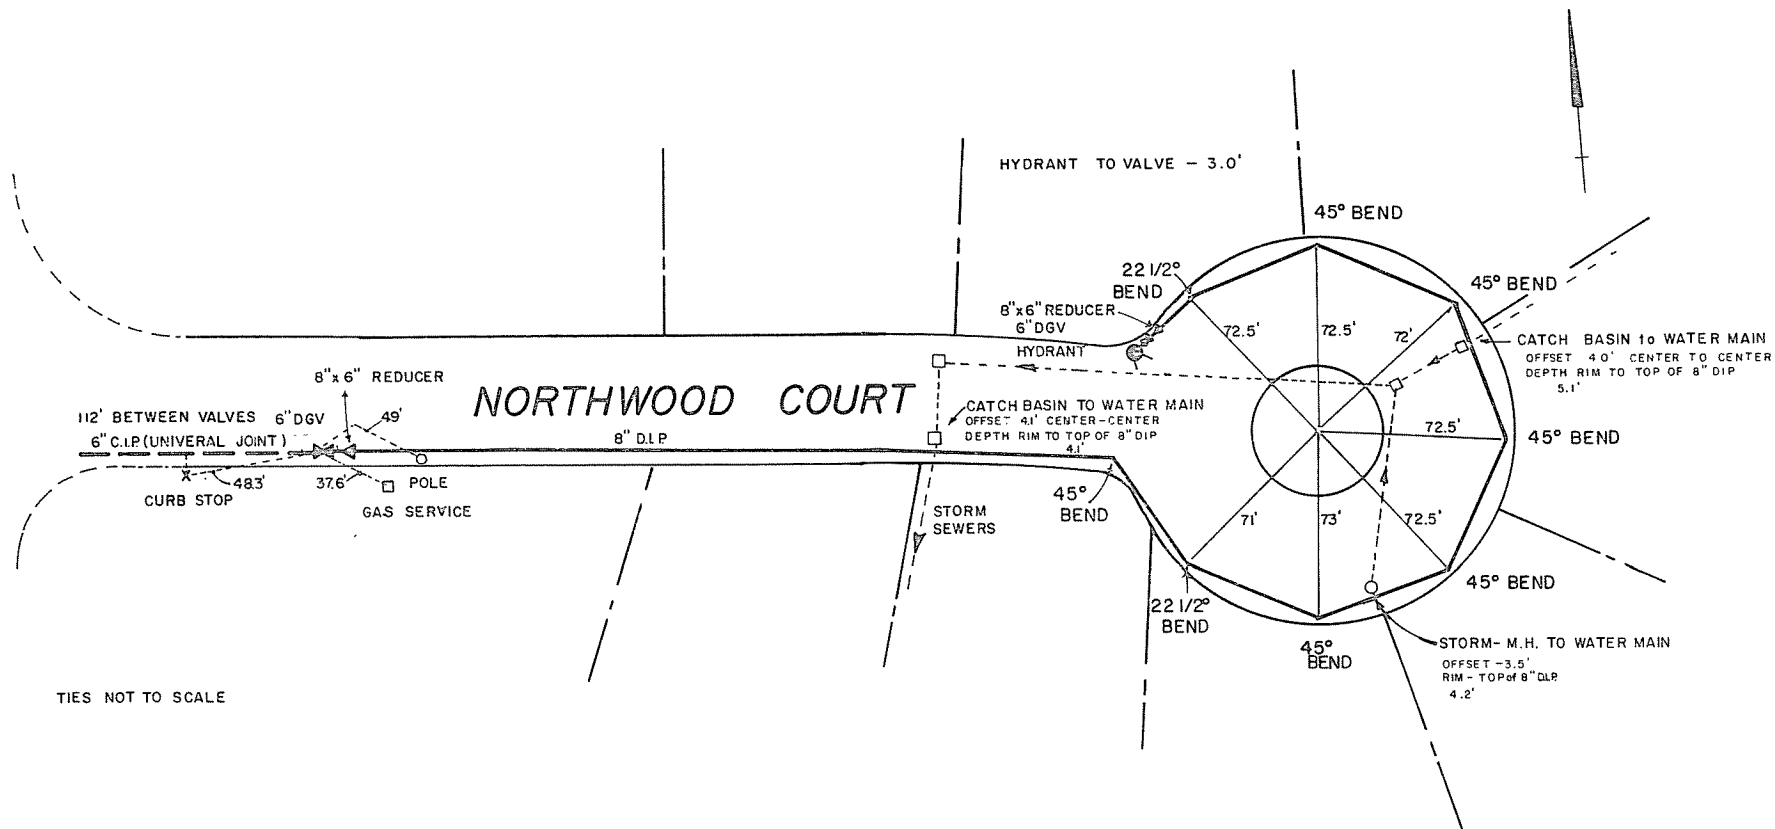

TIES NOT TO SCALE

CONSTRUCTED OCTOBER 1978 BY
HART CONSTRUCTION CO.
SOIL CONDITIONS - BROWN CLAY

DWN. BY: G.L.M.
CKD. BY: W.T.B.

NORTHWOOD COURT
WATER DISTRICT No. 1
TOWN OF BETHLEHEM
RECORD OF INSTALLATION
SCALE: 1" = 50' OCTOBER 1978
J. KENNETH FRASER & ASSOCIATES, P.C.
CONSULTING ENGINEERS RENSSELAER, N.Y.