


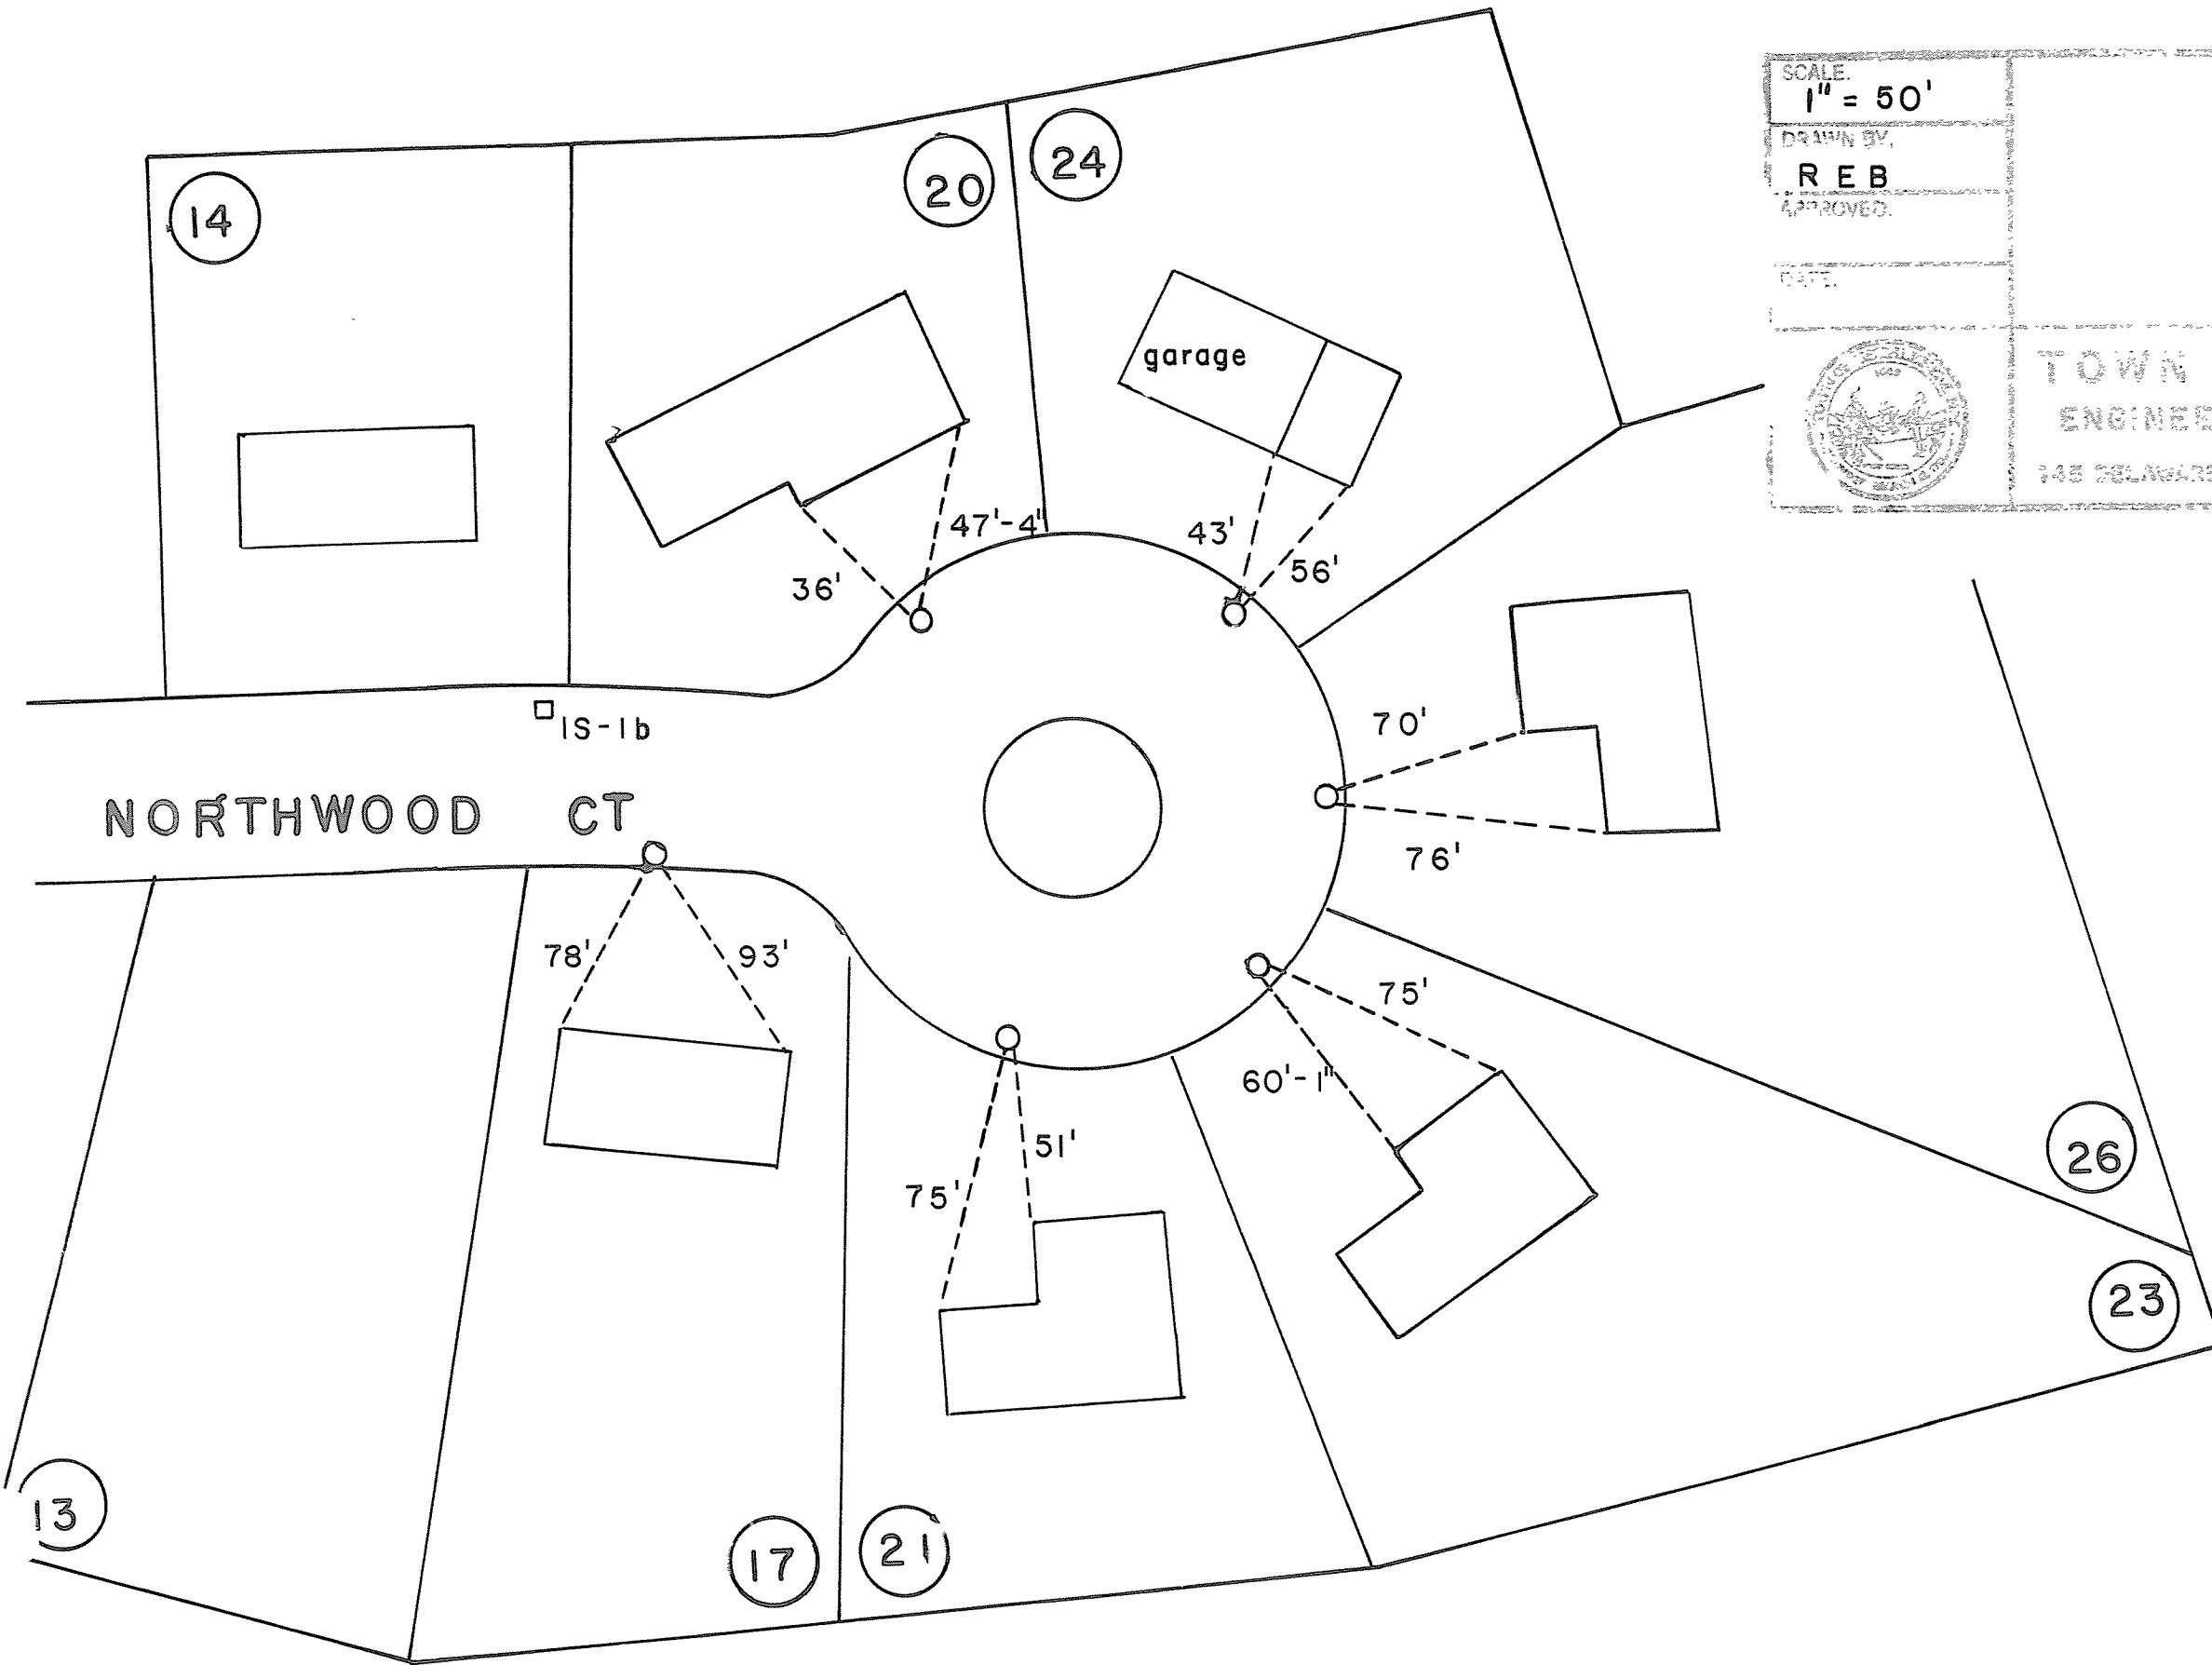

SCALE.
1" = 50'

DRAWN BY,
REB

APPROVED.

DATE.



TOWN OF REHLEIGH

ENGINEERING DEPARTMENT

438 DELAWARE AVE. DELMAR, DE 19701