


OAK ROAD  
LEAF ROAD  
WILLOW DRIVE

Existing Hydrant  
Connection To Existing  
6" & C.I. Main

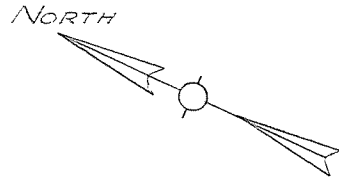

8" & WATER MAIN INSTALLED BY  
TOWN FORCES JULY 1972

CHERRY  
AVE.

Top Of 8" & D.I. Pipe  
4.6' Below C.B. Rim  
Top Of 8" & D.I. Pipe  
4.3' Below C.B. Rim  
37.8'  
8.3'  
3.8'  
8.8'

WILLOW  
DR.

Top Of 8" & D.I. Pipe  
3.3' Below C.B. Rim  
5.7'  
3.7'

Top Of 8" & D.I. Pipe  
4.9' Below C.B. Rim

Hydrant  
4.7'

Top Of 8" & D.I. Pipe  
5' Below C.B. Rim

8" & Sanitary Sewer

Existing 6" & Water Main  
24" Oak  
28.5'

LEAF  
ROAD

OAK ROAD  
THE COMMONS OF BETHLEHEM - SECTION 1  
WATER DISTRICT NO. 1

TOWN OF BETHLEHEM

Record of Installations  
Scale 1"=50' July 1972

J. Kenneth Fraser and Associates, P.C.  
Consulting Engineers Rensselaer, N.Y.

6" Tapping Sleeve & Valve  
Increasing To 8" & D.I. Pipe

18' Maple

76.1  
8.9  
House

1  
1