




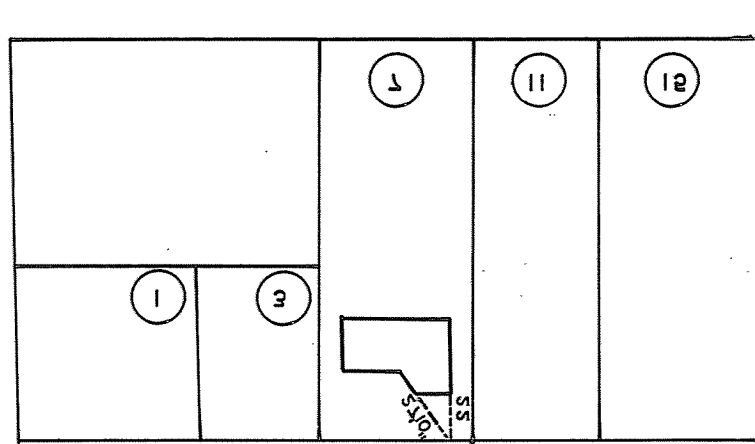

OAKWOOD

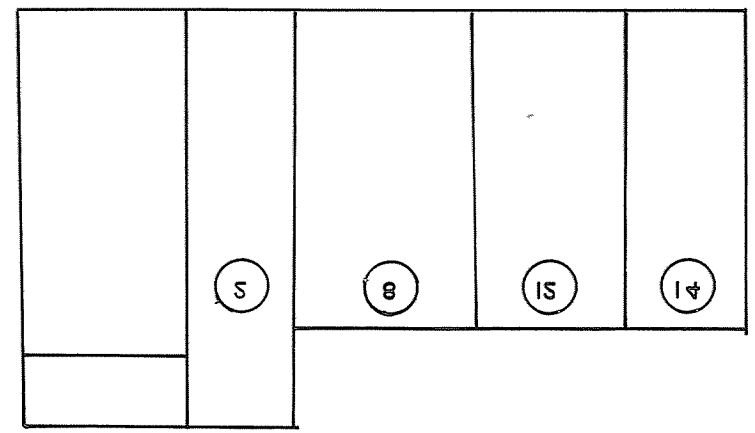


ADAMS

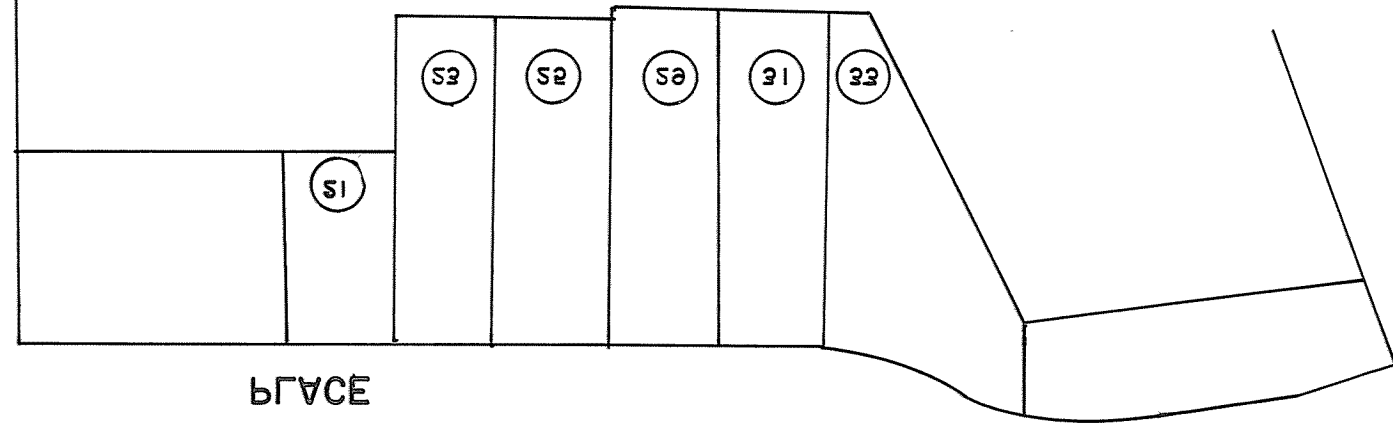

PLACE

ADAMS

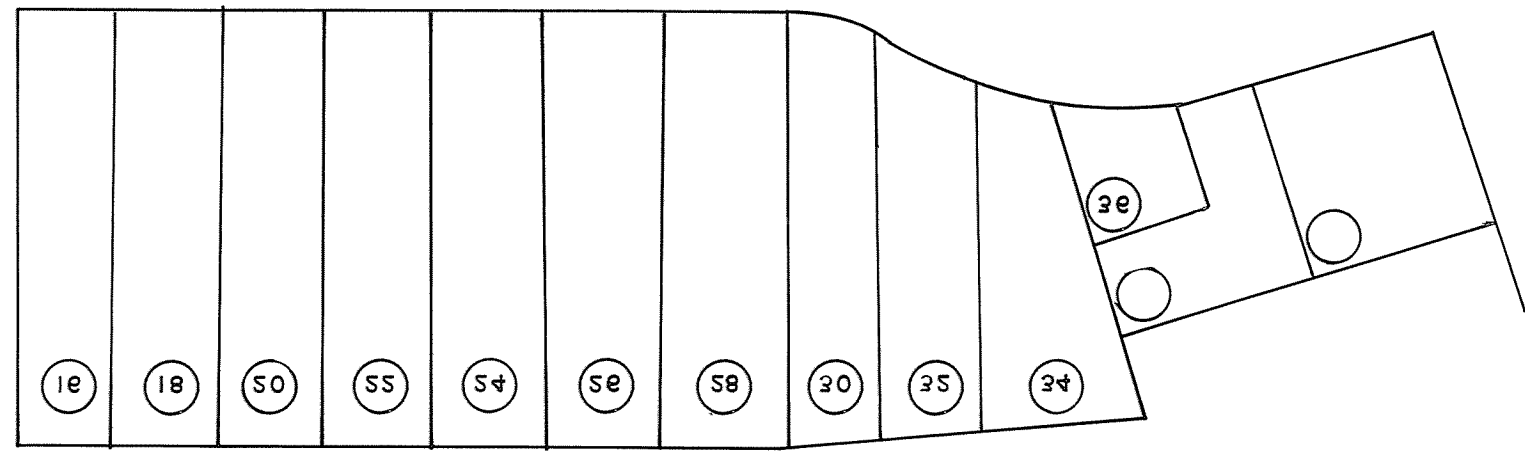

SCALE 1"=100,
TOWN OF BETHLEHEM ENGINEERING DEPT
RECORD OF INSTALLATION
TOWN OF BETHLEHEM
WATER DISTRICT NO 1
OAKWOOD PLACE
OCTOBER, 1984
DMM BY CES