


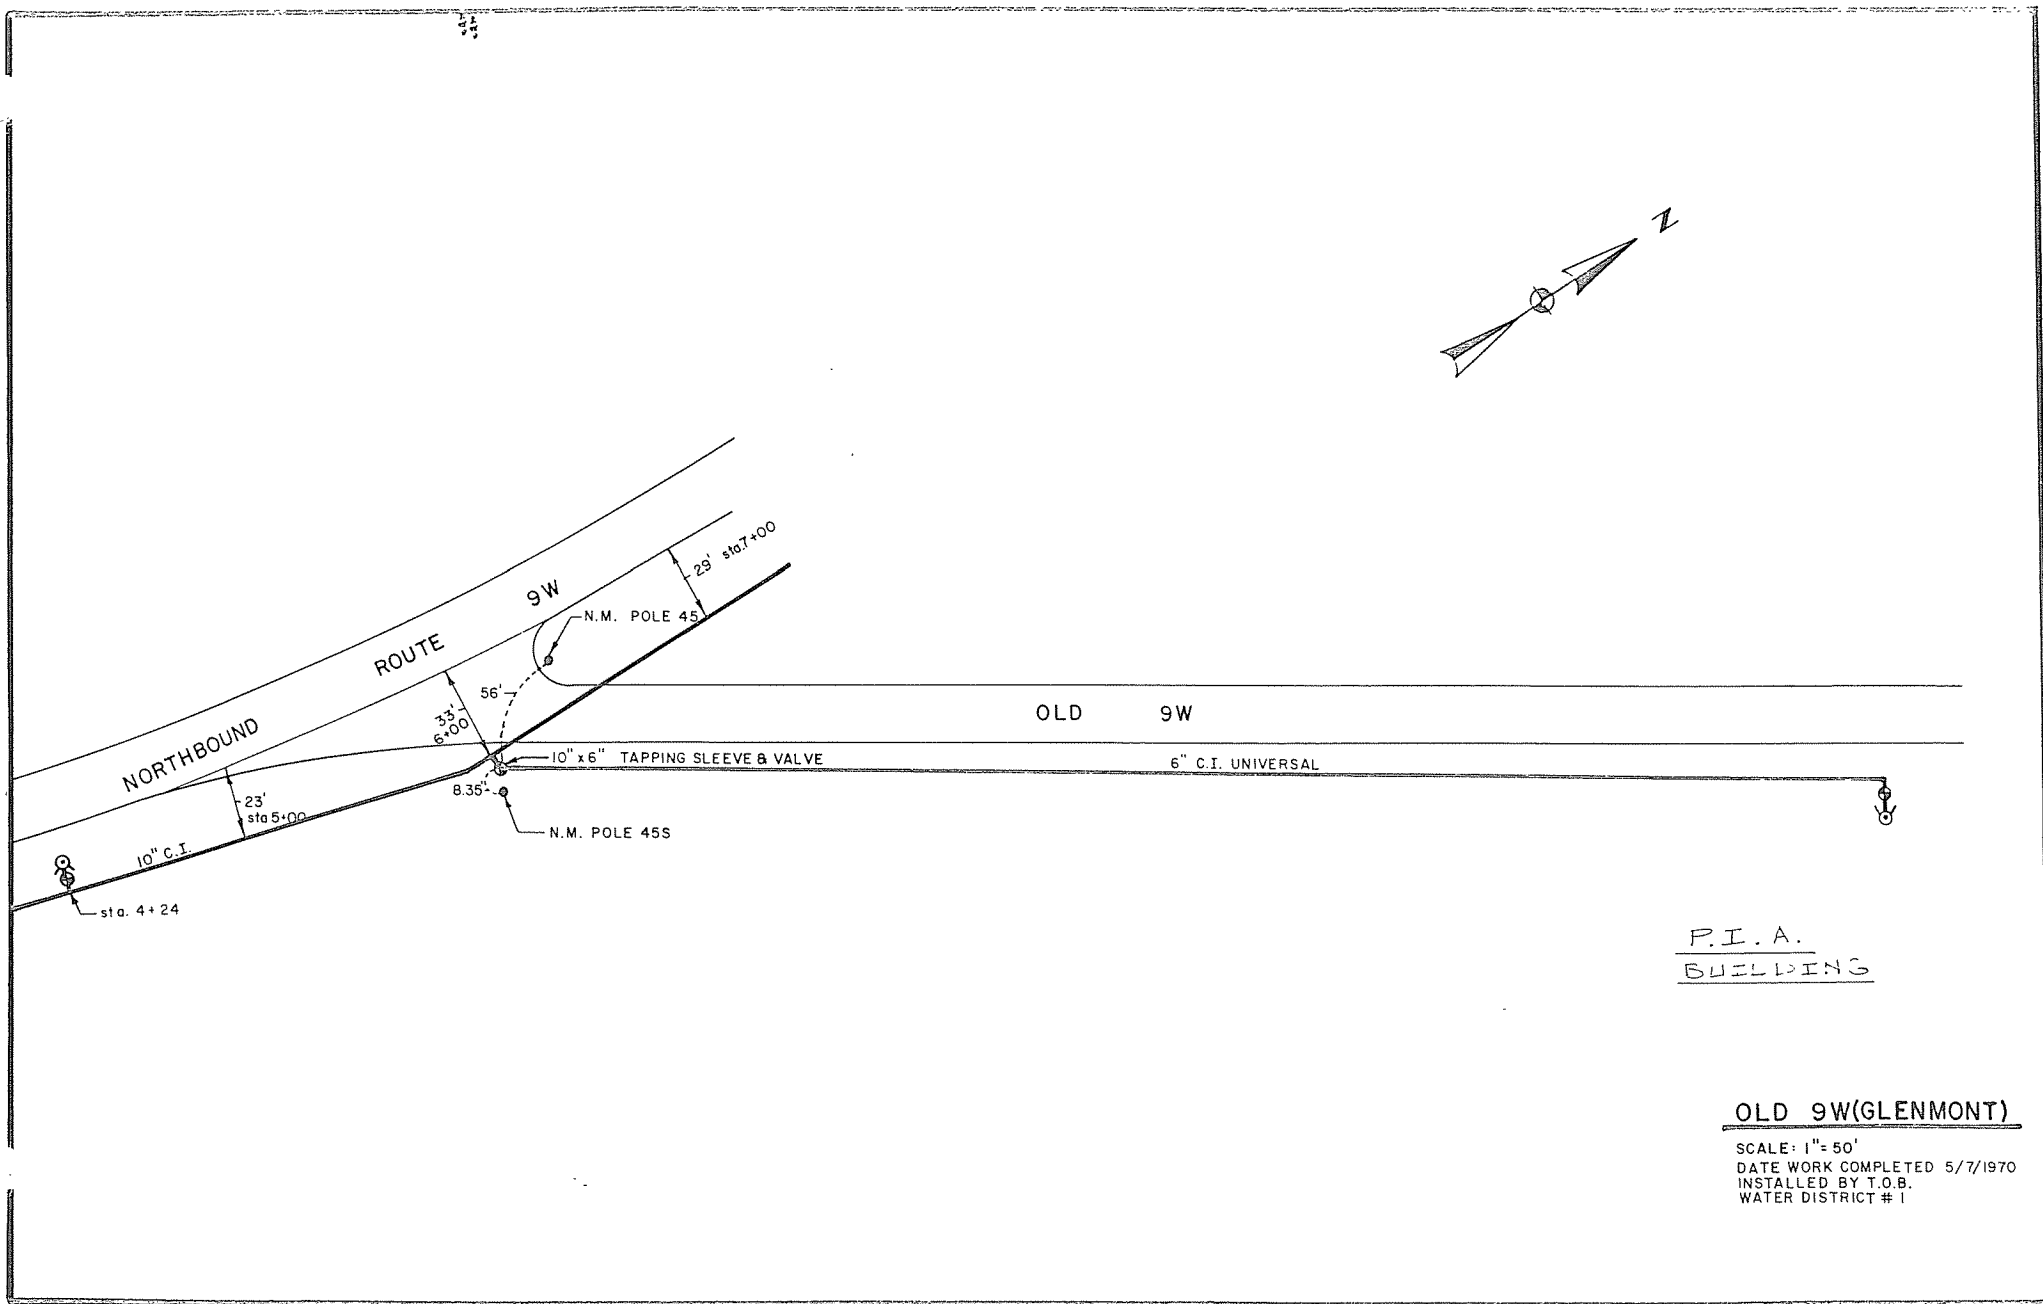

P.I.A.
BUILDING

OLD 9W(GLENMONT)

SCALE: 1"= 50'
DATE WORK COMPLETED 5/7/1970
INSTALLED BY T.O.B.
WATER DISTRICT # 1