


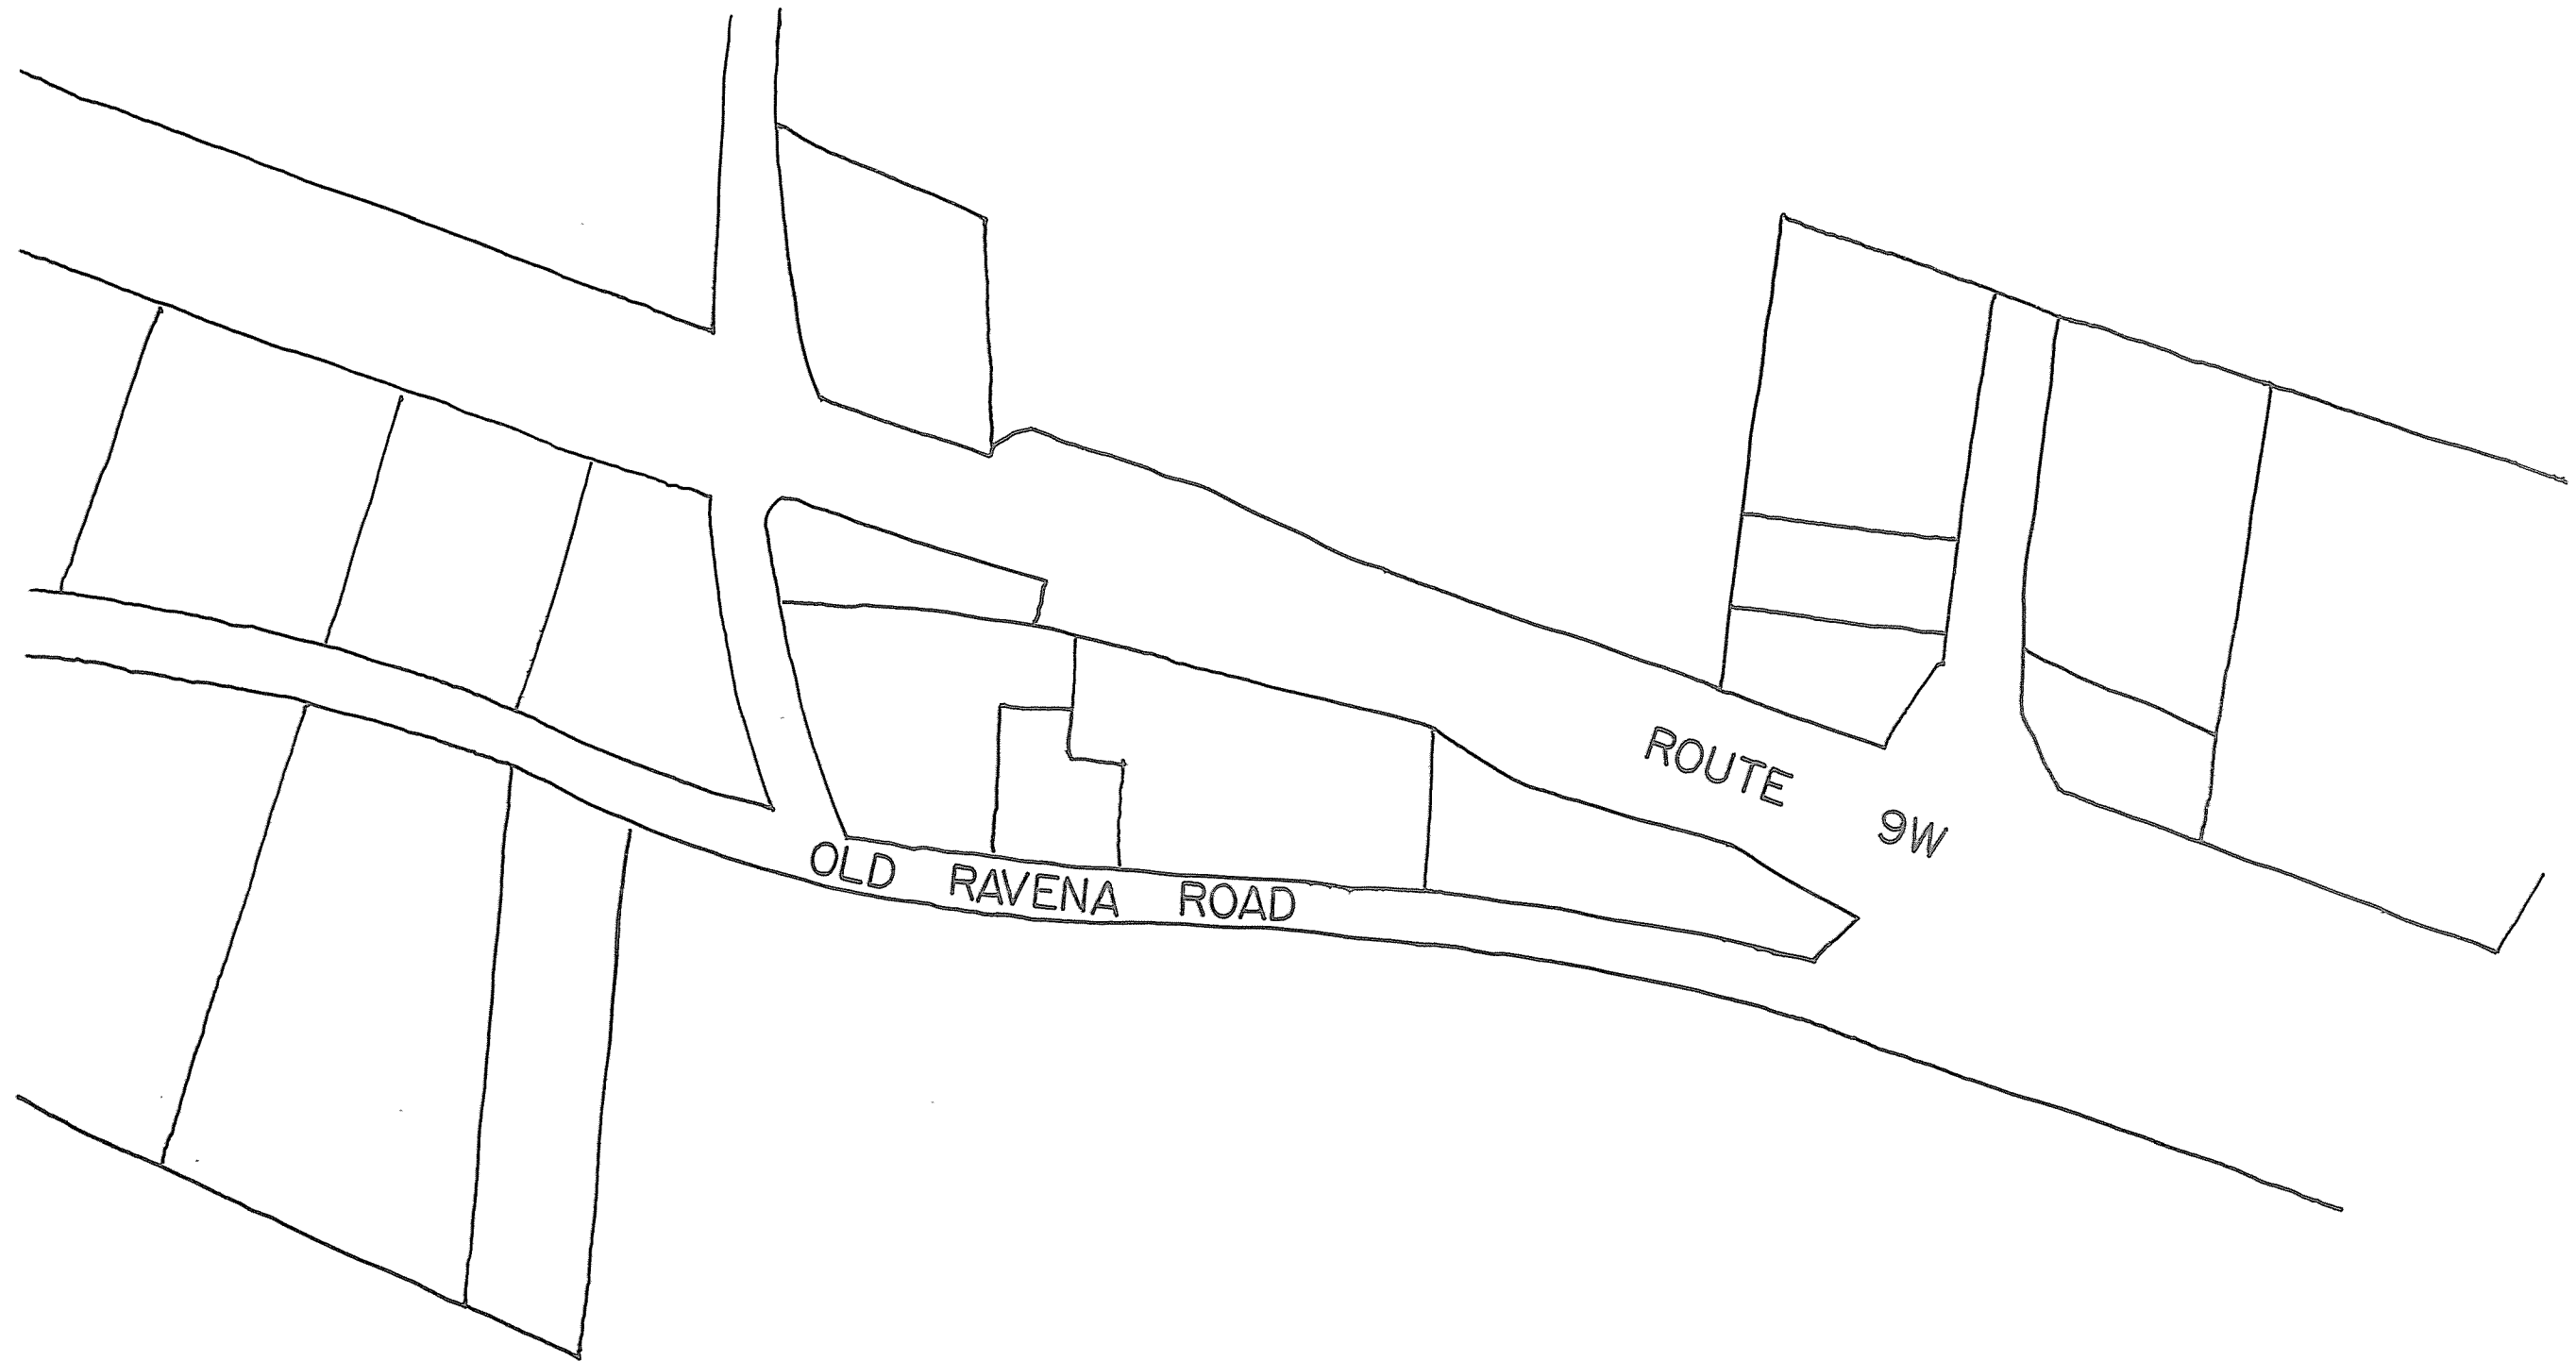

OLD RAVENA ROAD