
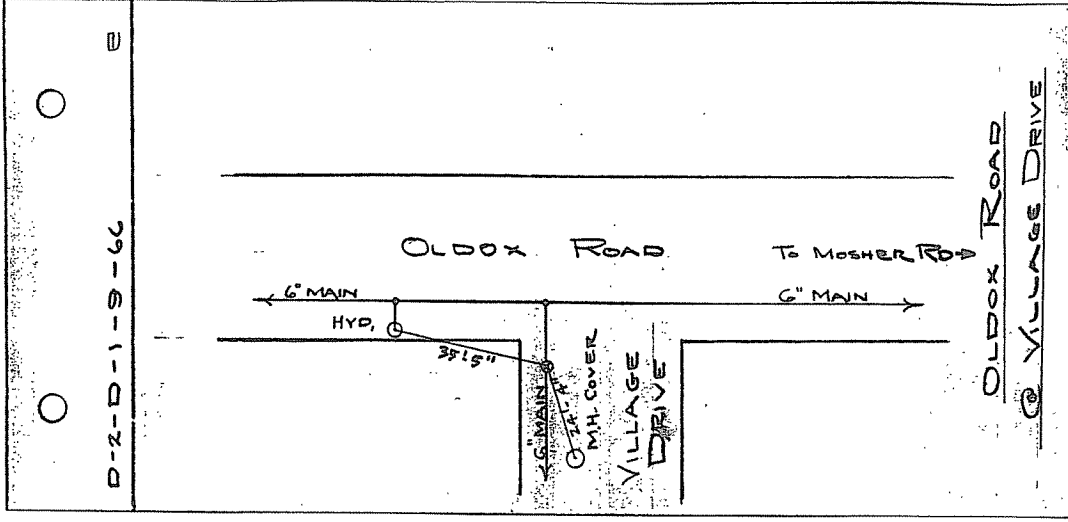


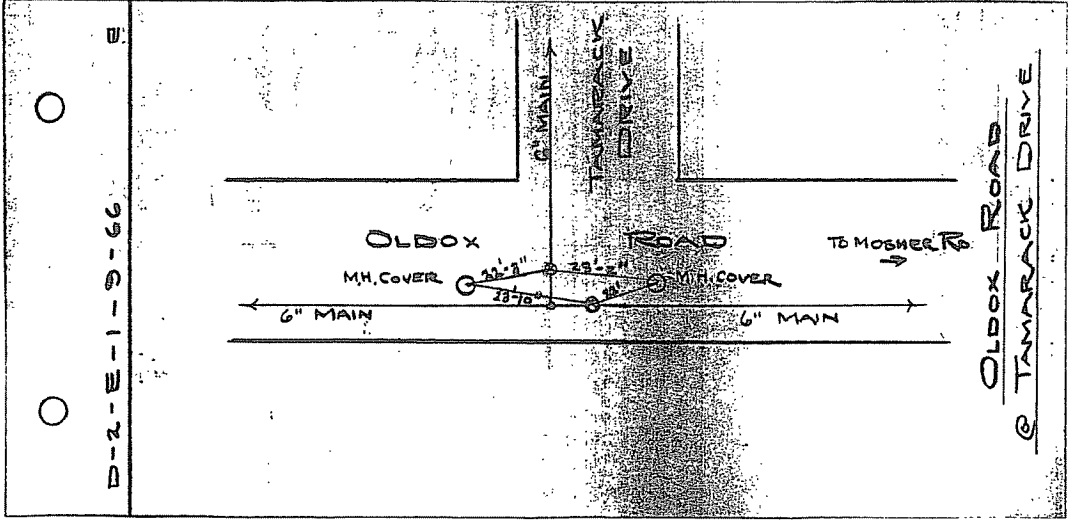

OLD OX ROAD
WATER MAIN