


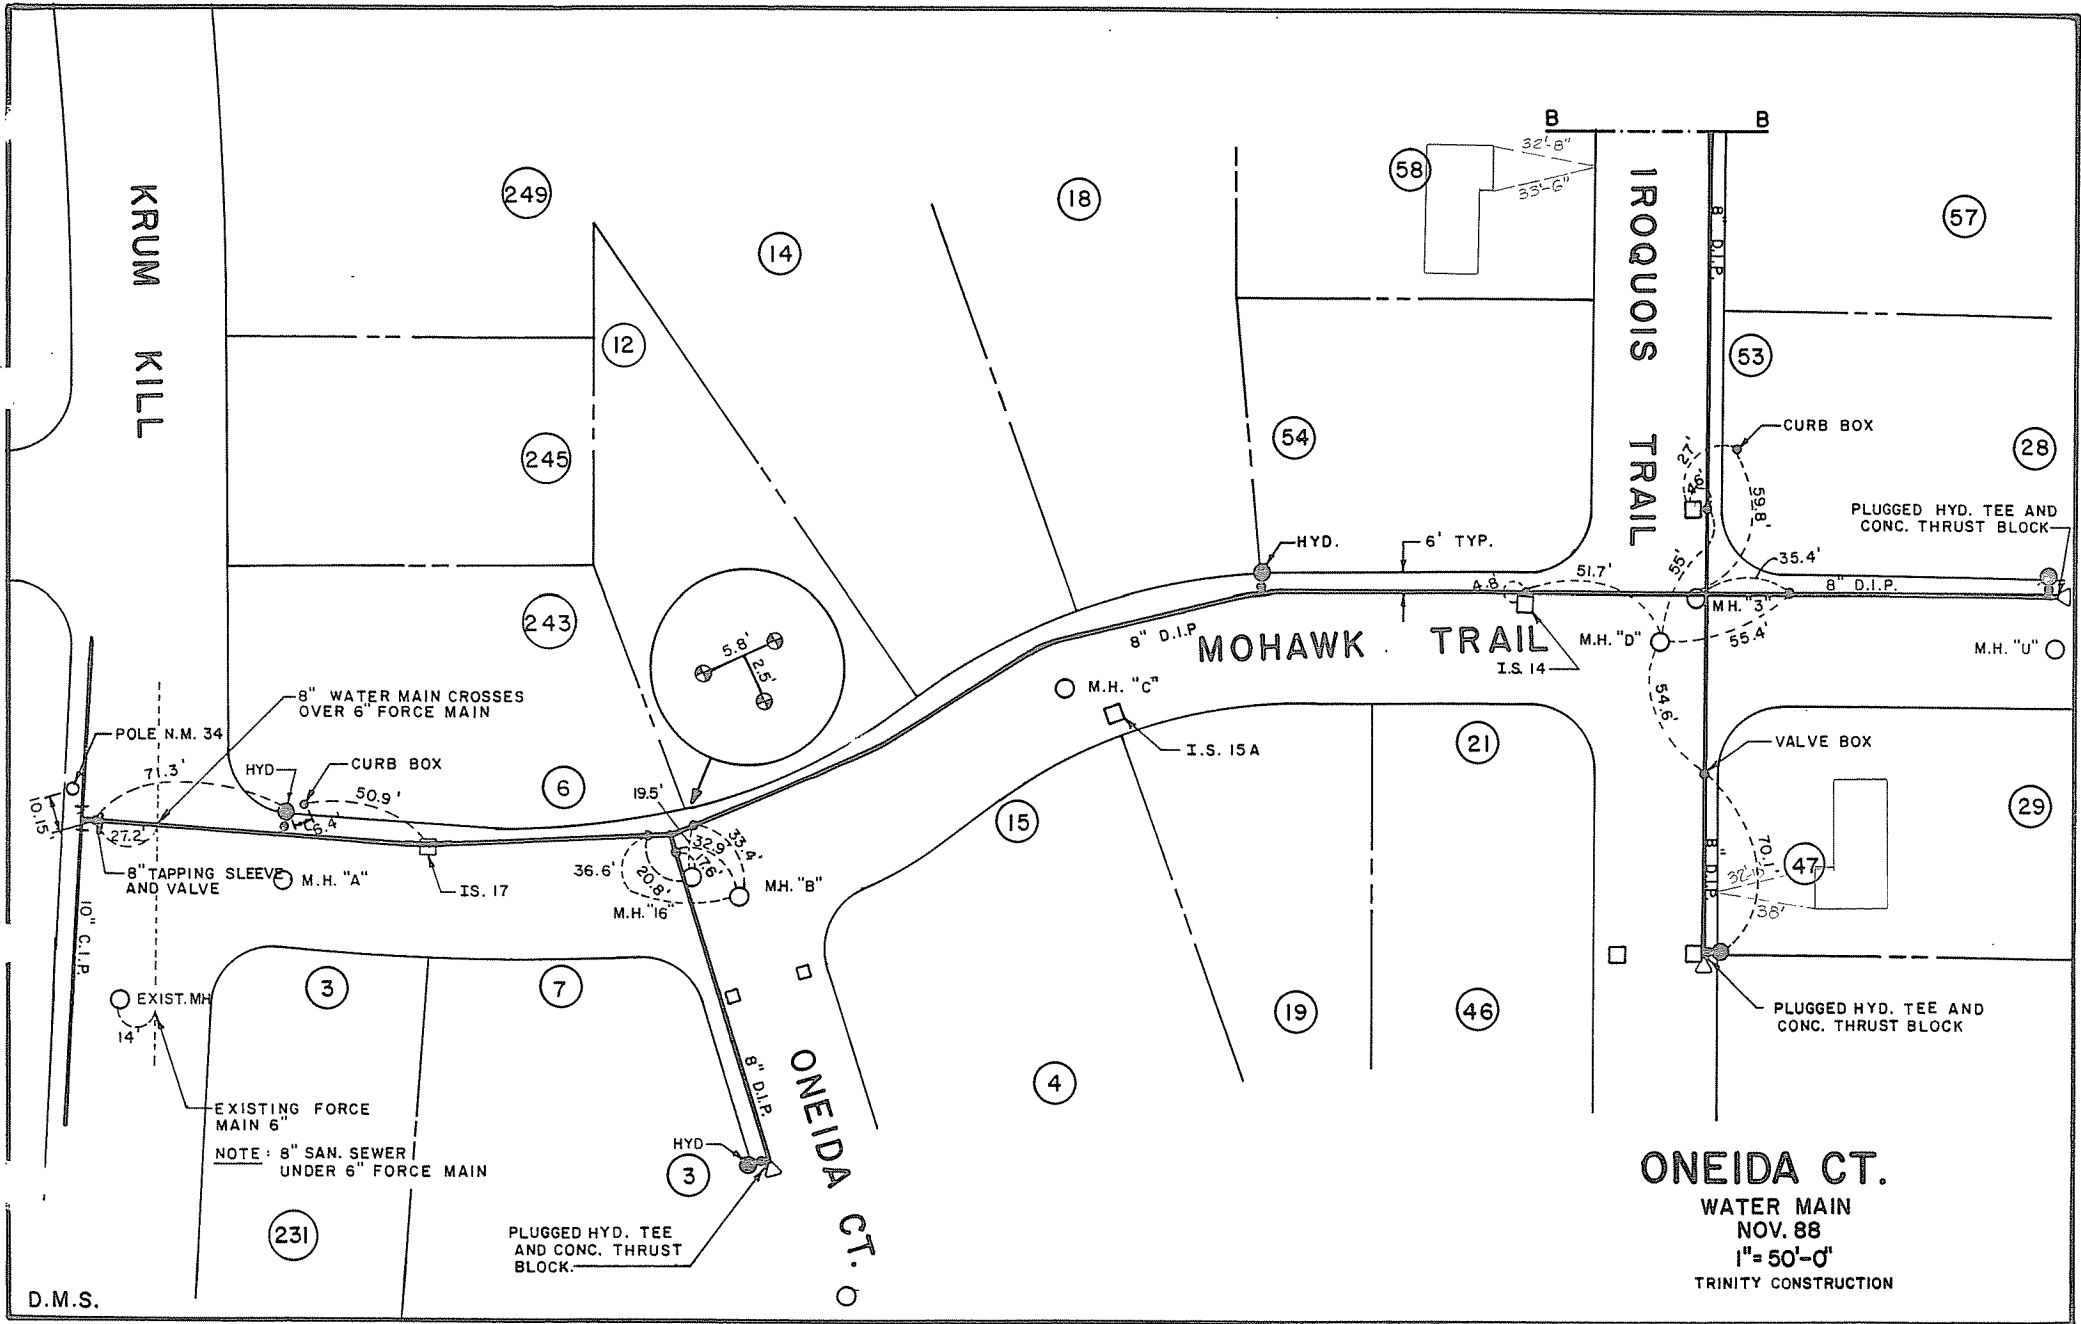

KRUM KILL

IROQUOIS TRAIL

MOHAWK TRAIL

ONEIDA CT.

ONEIDA CT.

WATER MAIN
NOV. 88

1" = 50'-0"

TRINITY CONSTRUCTION

D.M.S.