


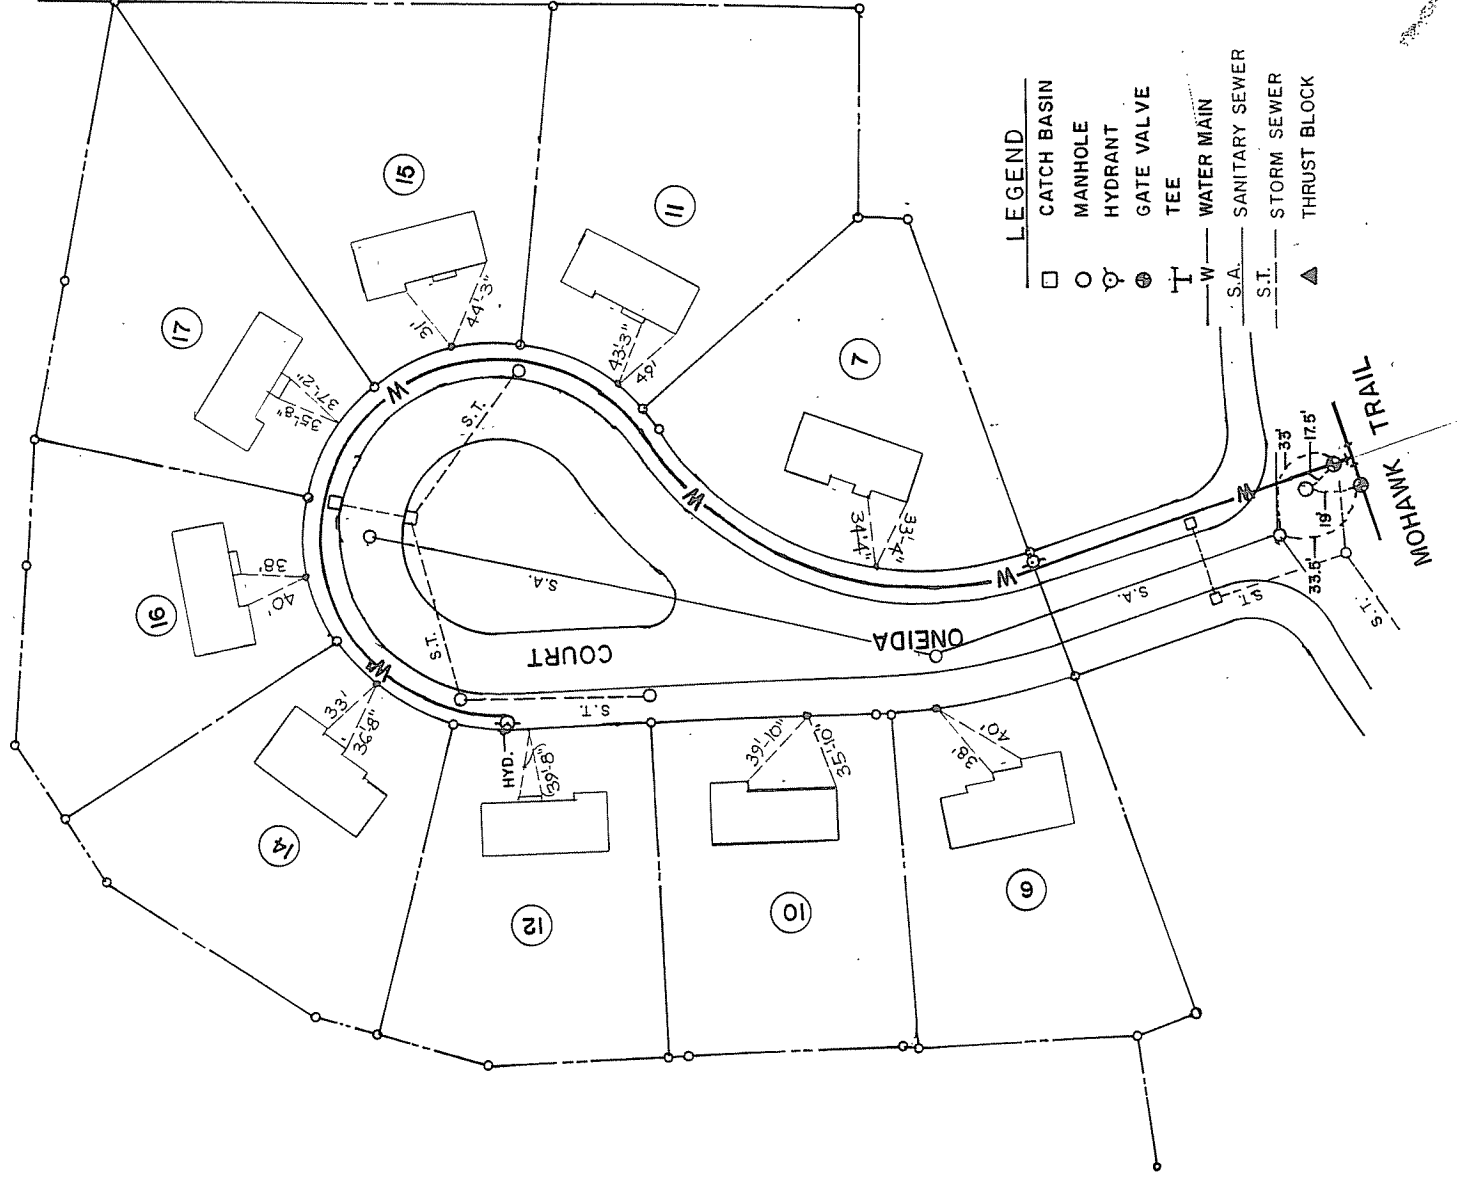

LEGEND

- CATCH BASIN
- MANHOLE
- ⊕ HYDRANT
- ⊗ GATE VALVE
- ⊥ TEE
- W — WATER MAIN
- S.A. — SANITARY SEWER
- S.T. — STORM SEWER
- ▲ THRUST BLOCK

ONEIDA TRAIL
INDIAN HILLS
SECTION No. 3
WATER MAIN & CURBBOXES
SCALE: 1"=50' APRIL 1994

DRAWN BY: M.G.
CHECKED BY: T.W.R.