
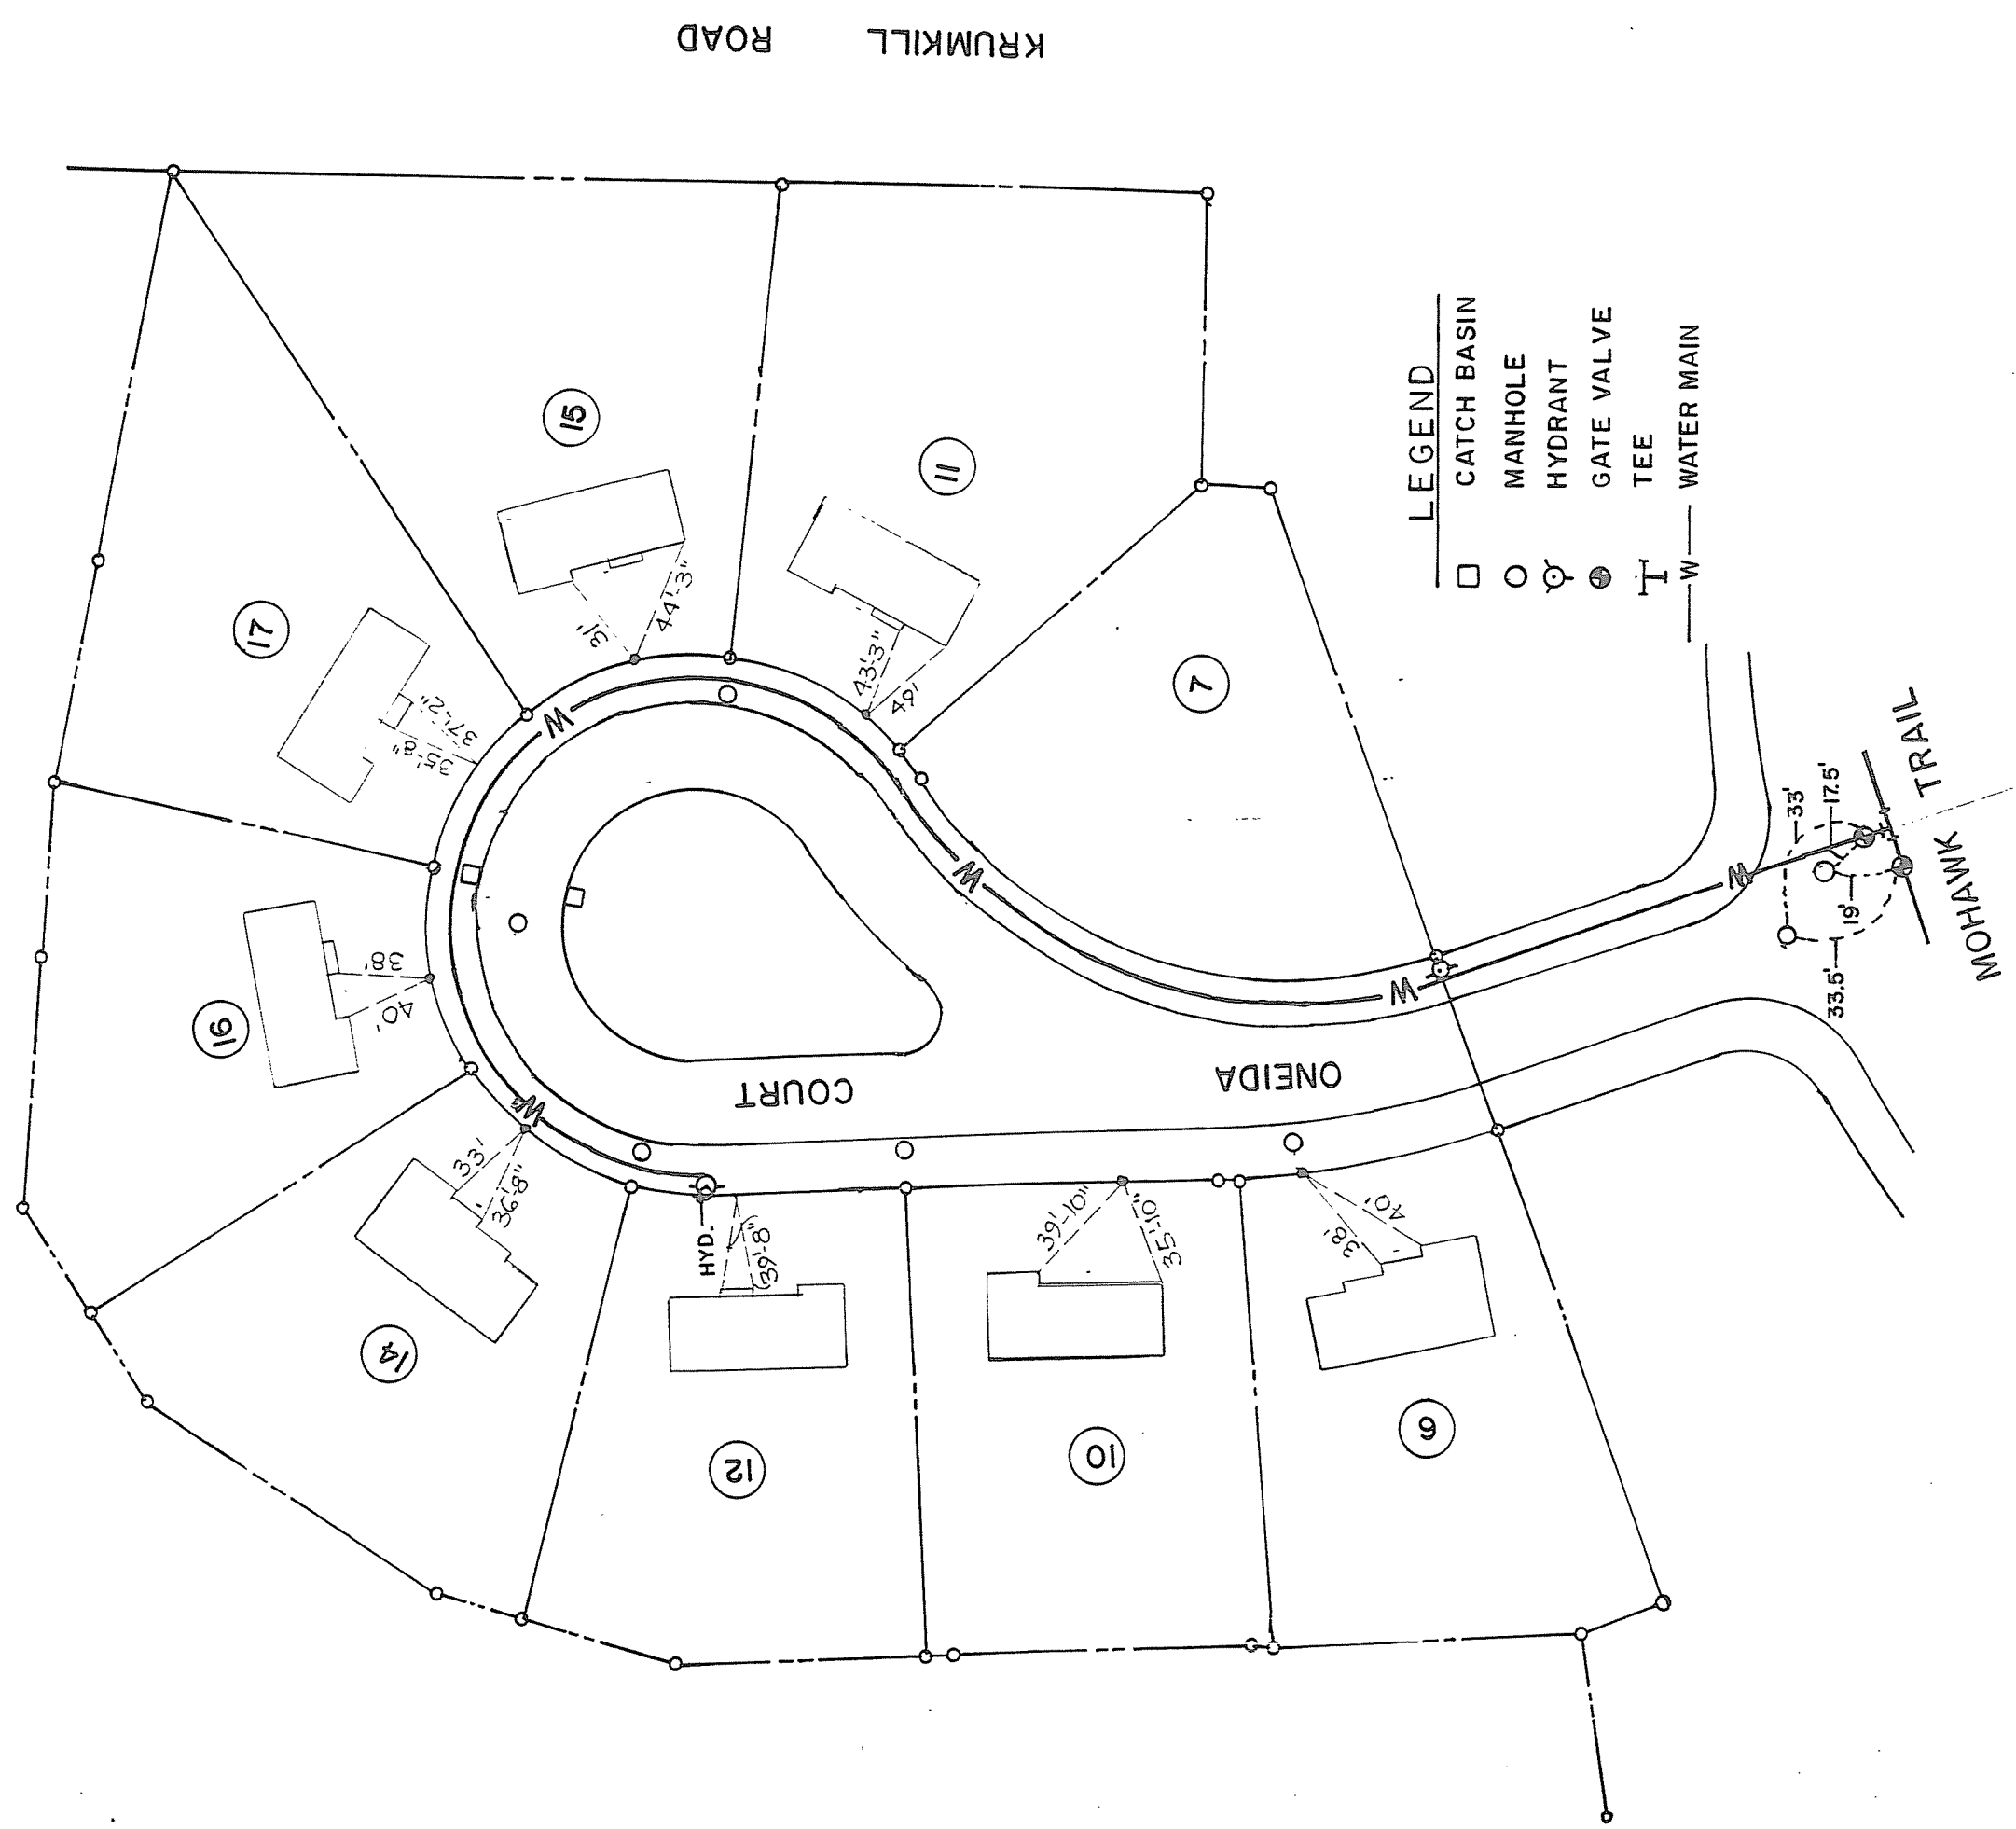


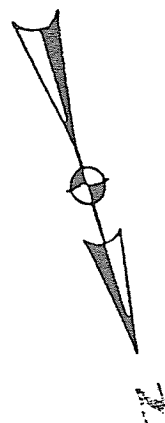

DRAWN BY: M.G.
CHECKED BY: T.W.R.