
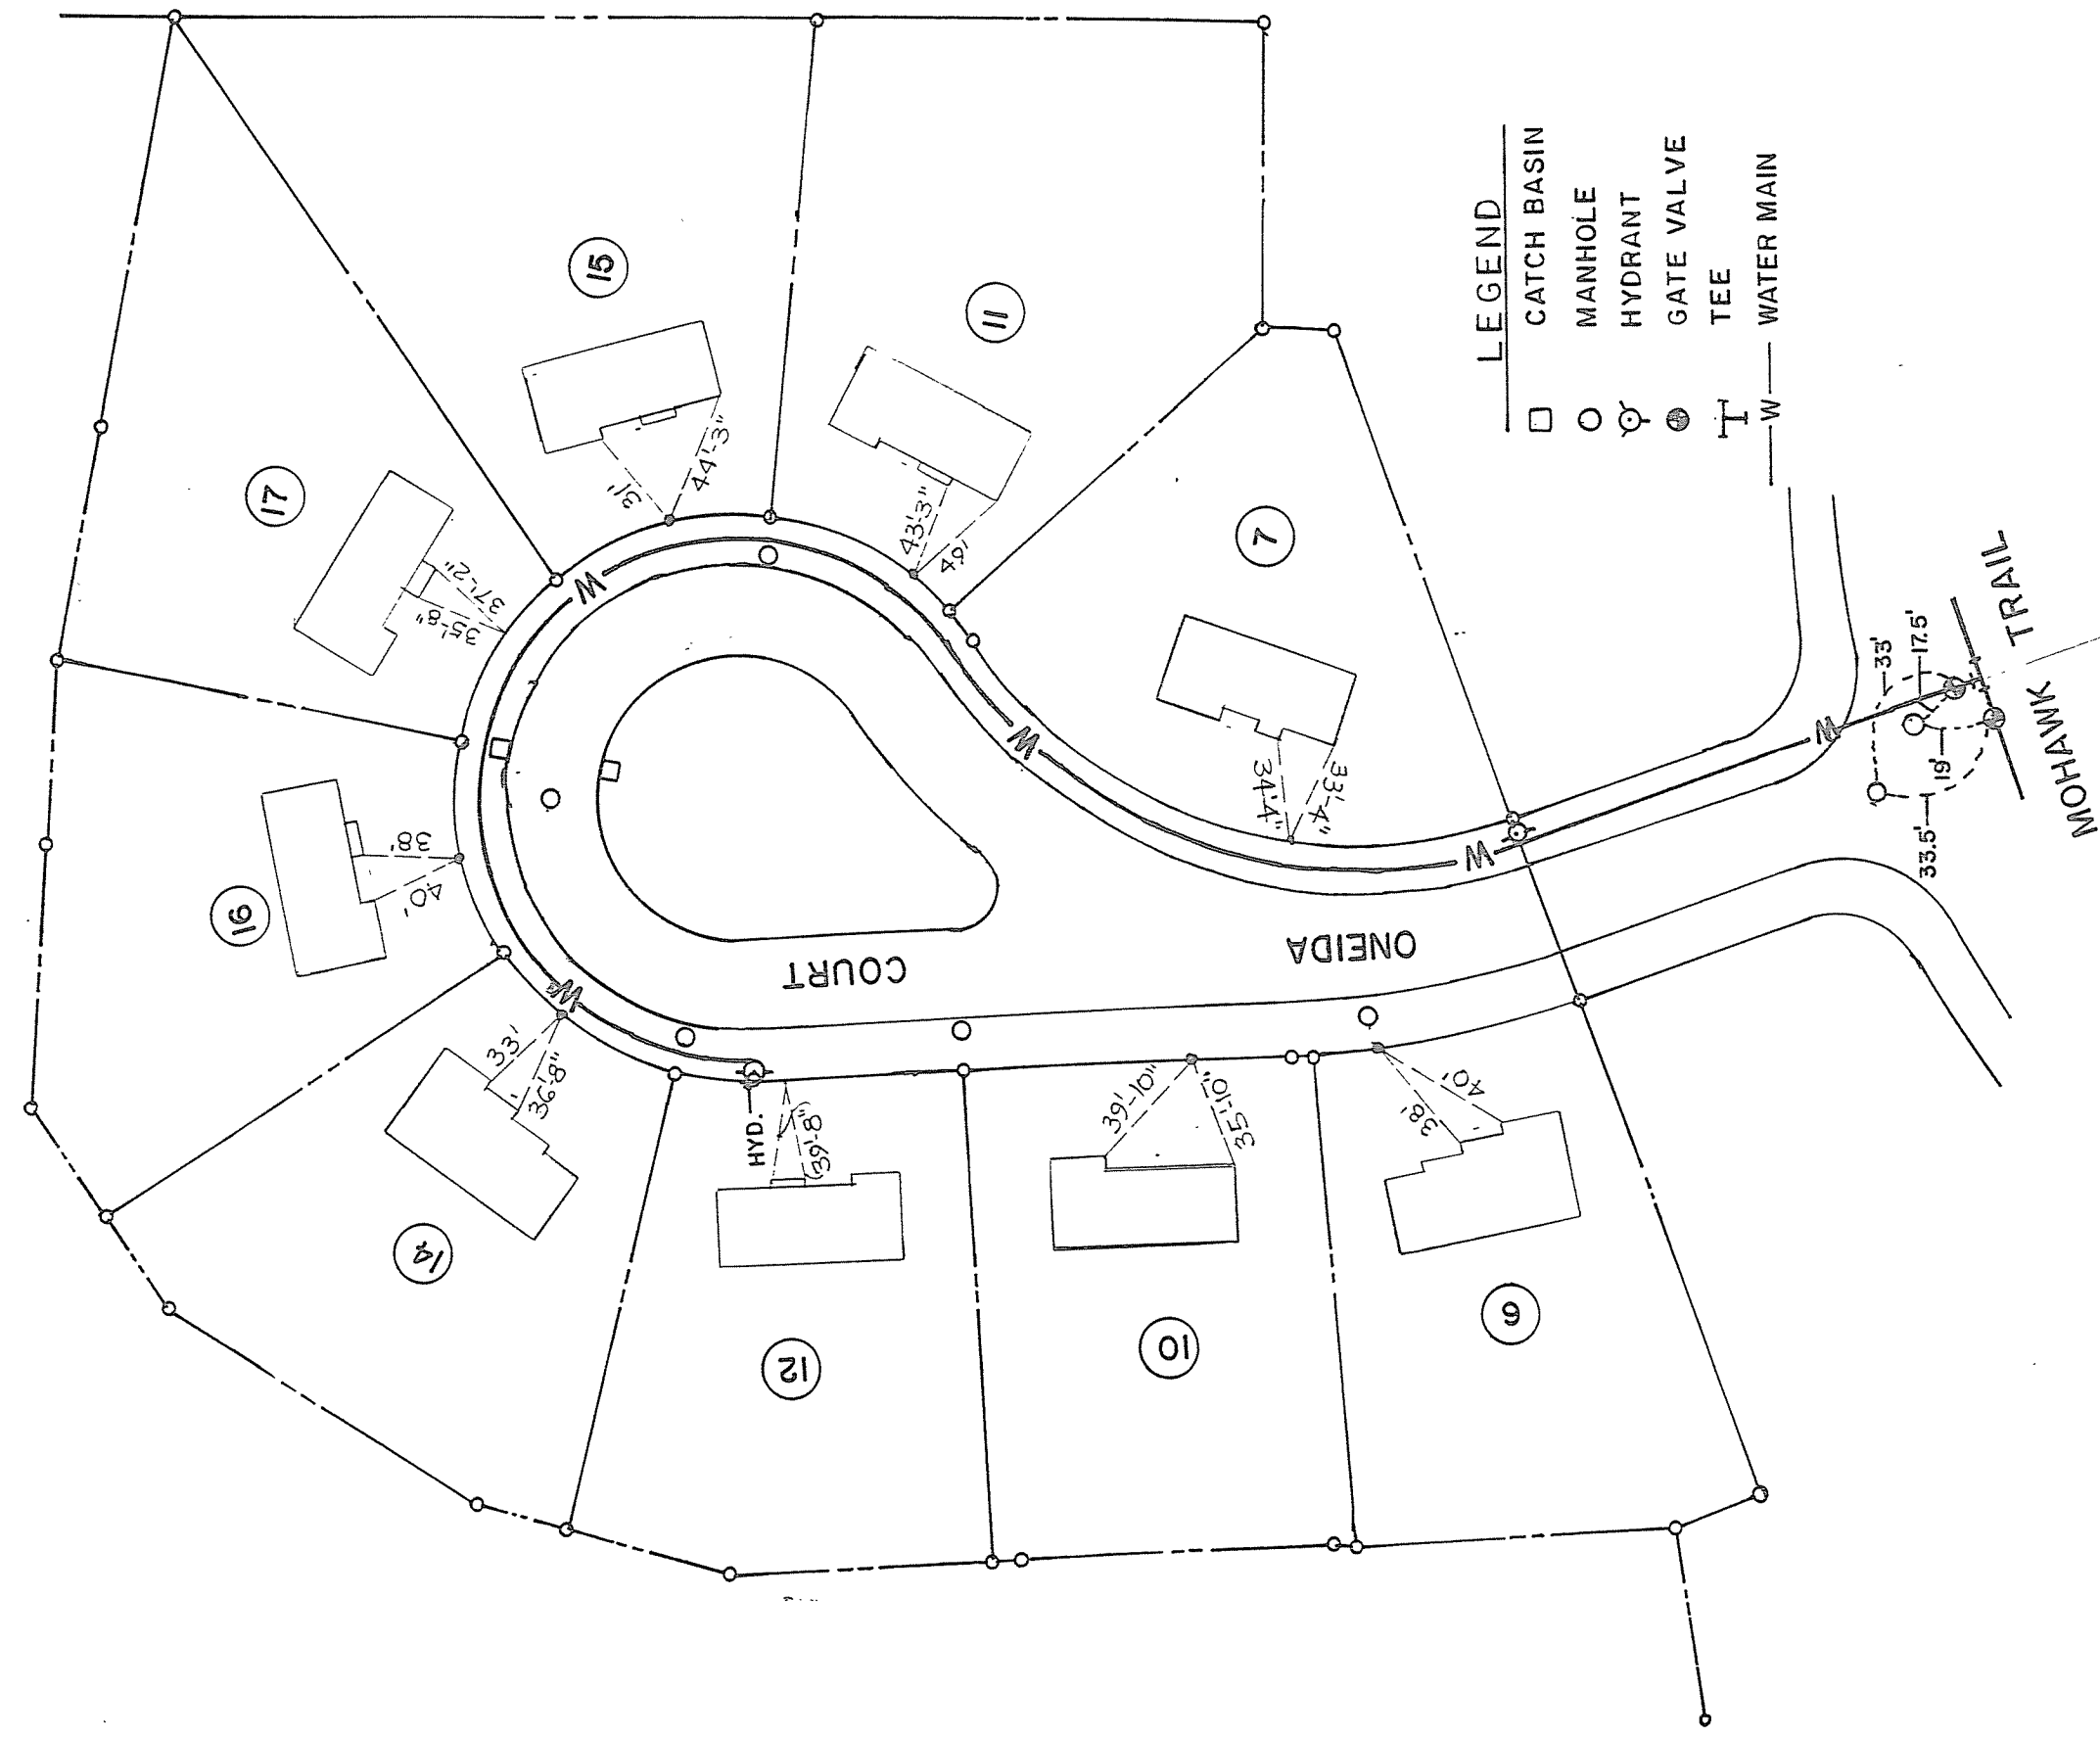


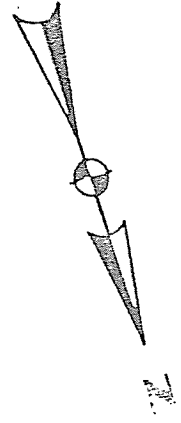

- LEGEND
- CATCH BASIN
 - MANHOLE
 - HYDRANT
 - GATE VALVE
 - TEE
 - WATER MAIN

ONEIDA TRAIL
INDIAN HILLS
SECTION No. 3
WATER MAIN & CURBBOXES
SCALE: 1"=50' APRIL 1994

DRAWN BY: M.G.
CHECKED BY: T.W.R.