



ORCHARD STREET  
WATER DISTRICT NO. 1  
TOWN OF BETHLEHEM  
RECORD OF INSTALLATION  
TOWN OF BETHLEHEM ENGINEERING  
DEPARTMENT  
SCALE: 1"=50' DECEMBER, 1982  
DWN. BY: PDH

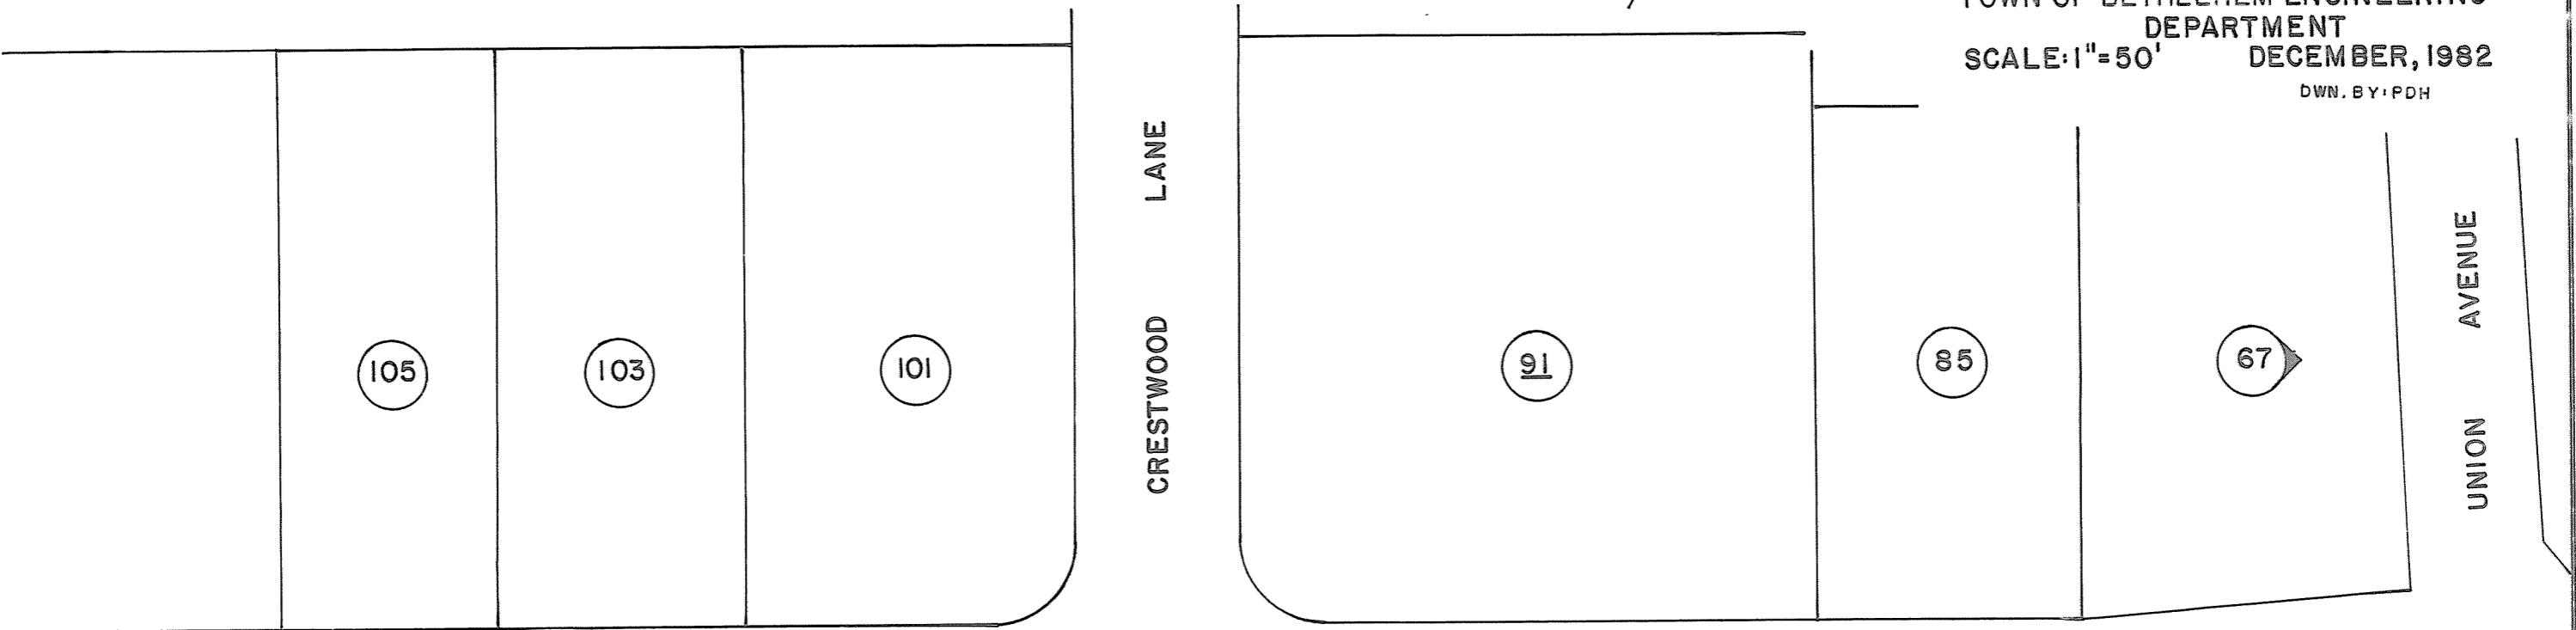


ORCHARD

STREET

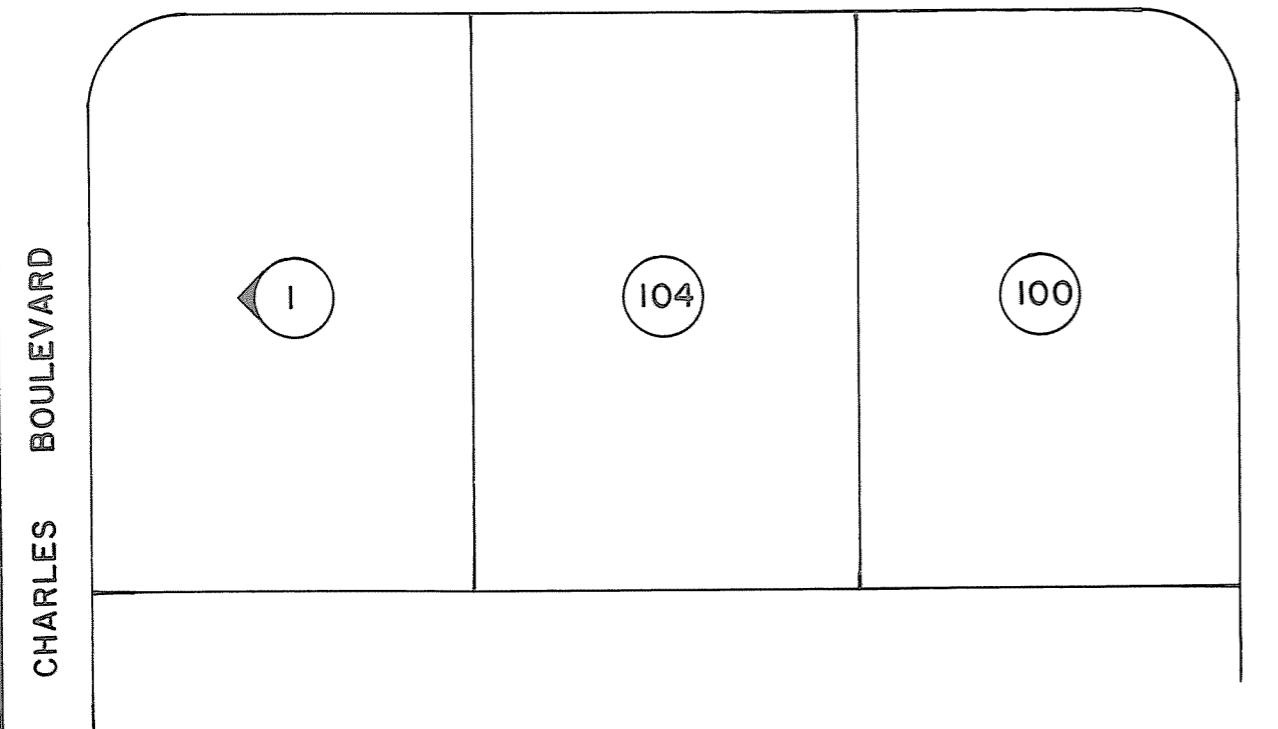

CHARLES BOULEVARD

ELWOOD ROAD

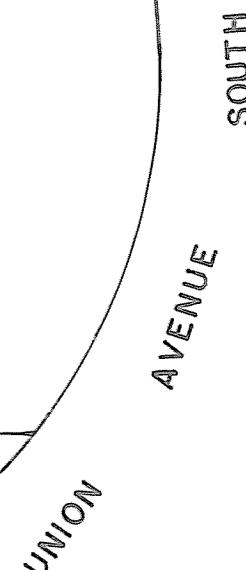

SOUTH

AVENUE

UNION