
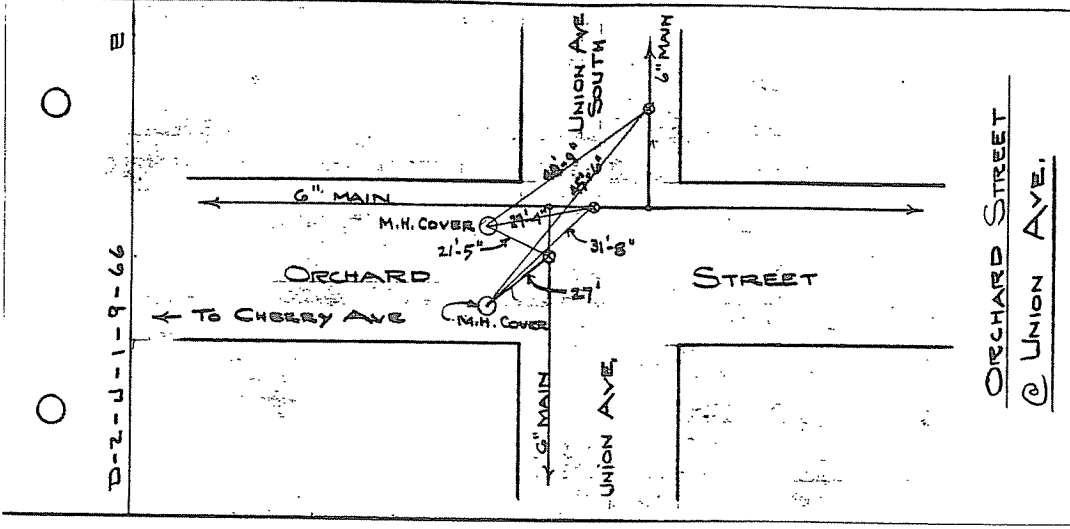


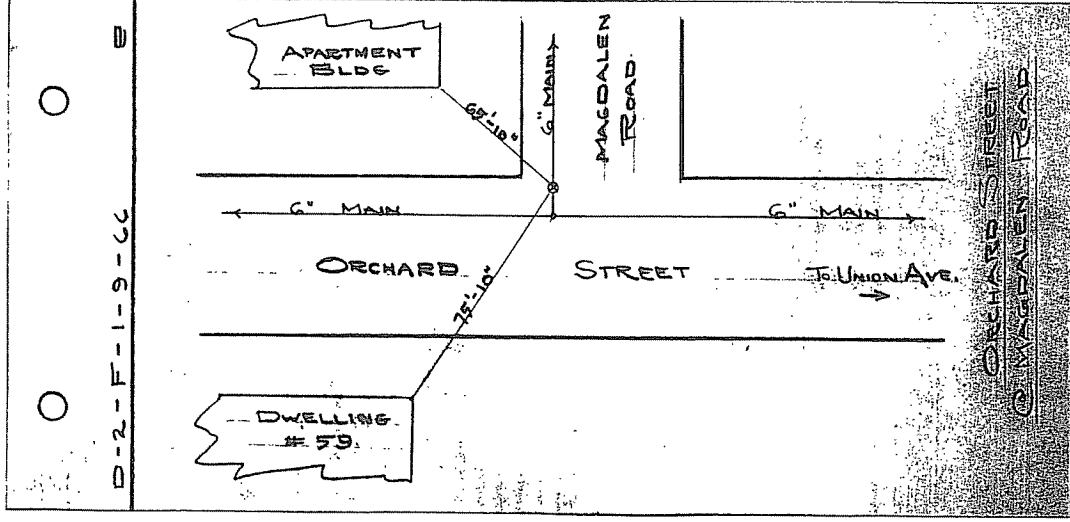

ORCHARD STREET
WATER MAIN