


PALMER AVENUE
WATER DISTRICT NO. 1
TOWN OF BETHLEHEM
RECORD OF INSTALLATION
TOWN OF BETHLEHEM ENGINEERING
DEPARTMENT
SCALE: 1"=50' MARCH, 1982
DWN. BY: PDH

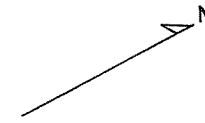

AVENUE

43

51

DOUGLAS ROAD

48

322

ROAD

PALMER

AVENUE

FERNBANK

53

6

CLARKSON ROAD

5

64

WELLINGTON