


PALMER AVENUE
WATER DISTRICT NO. 1
TOWN OF BETHLEHEM

RECORD OF INSTALLATION
TOWN OF BETHLEHEM ENGINEERING
DEPARTMENT
SCALE: 1" = 50'
MARCH, 1982
DWN. BY: PDH



PALMER AVENUE

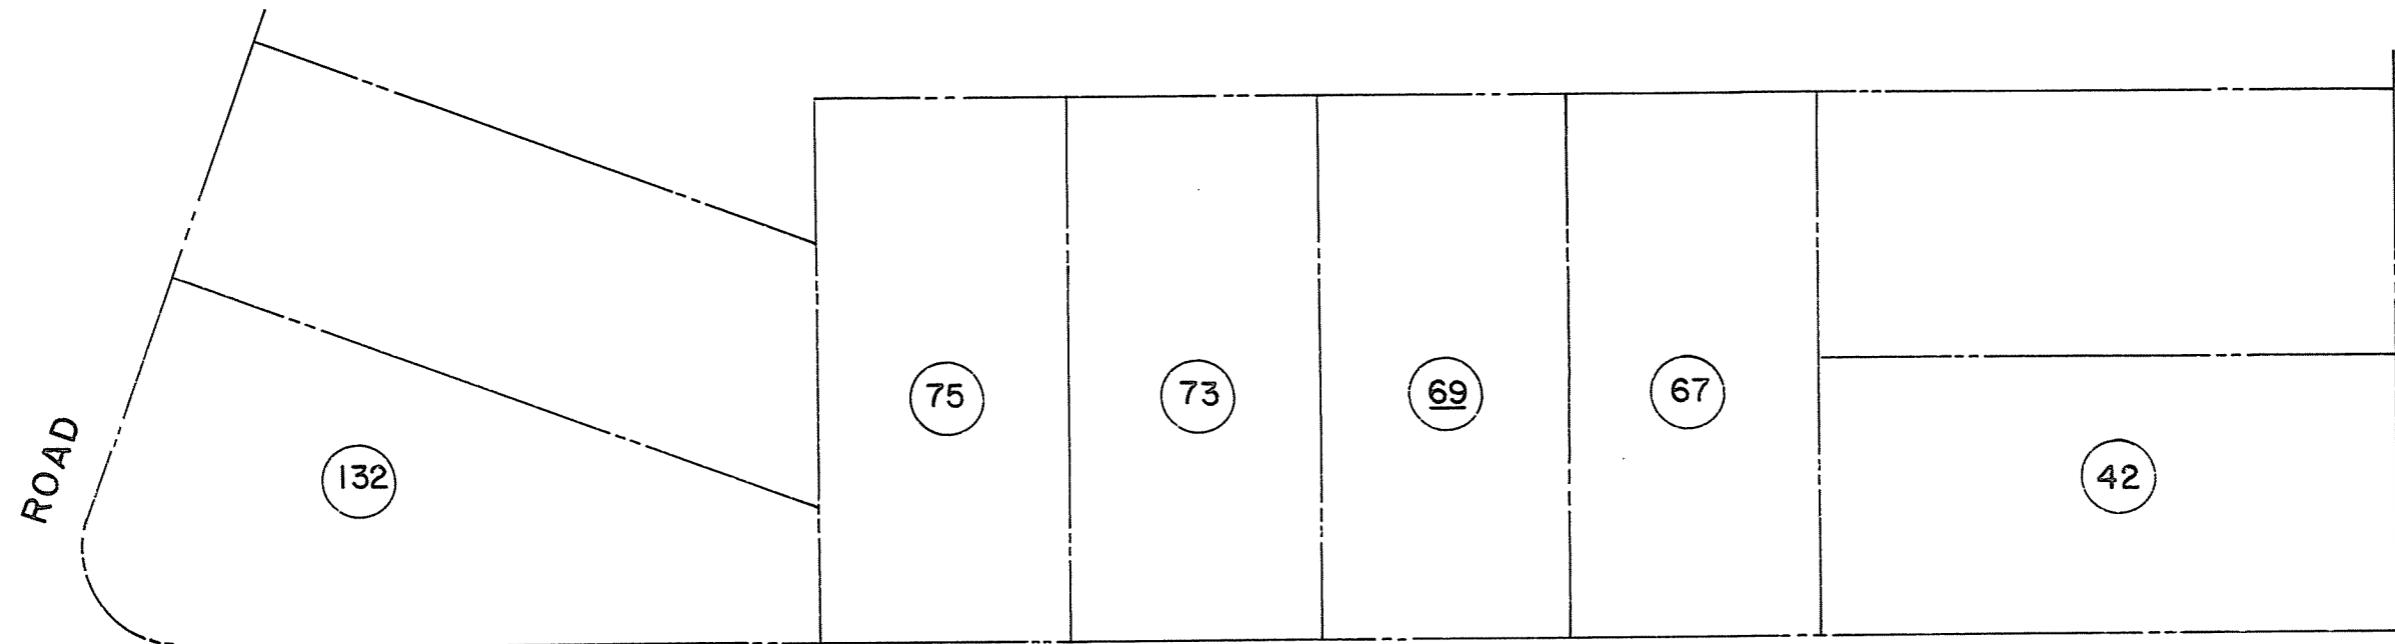