
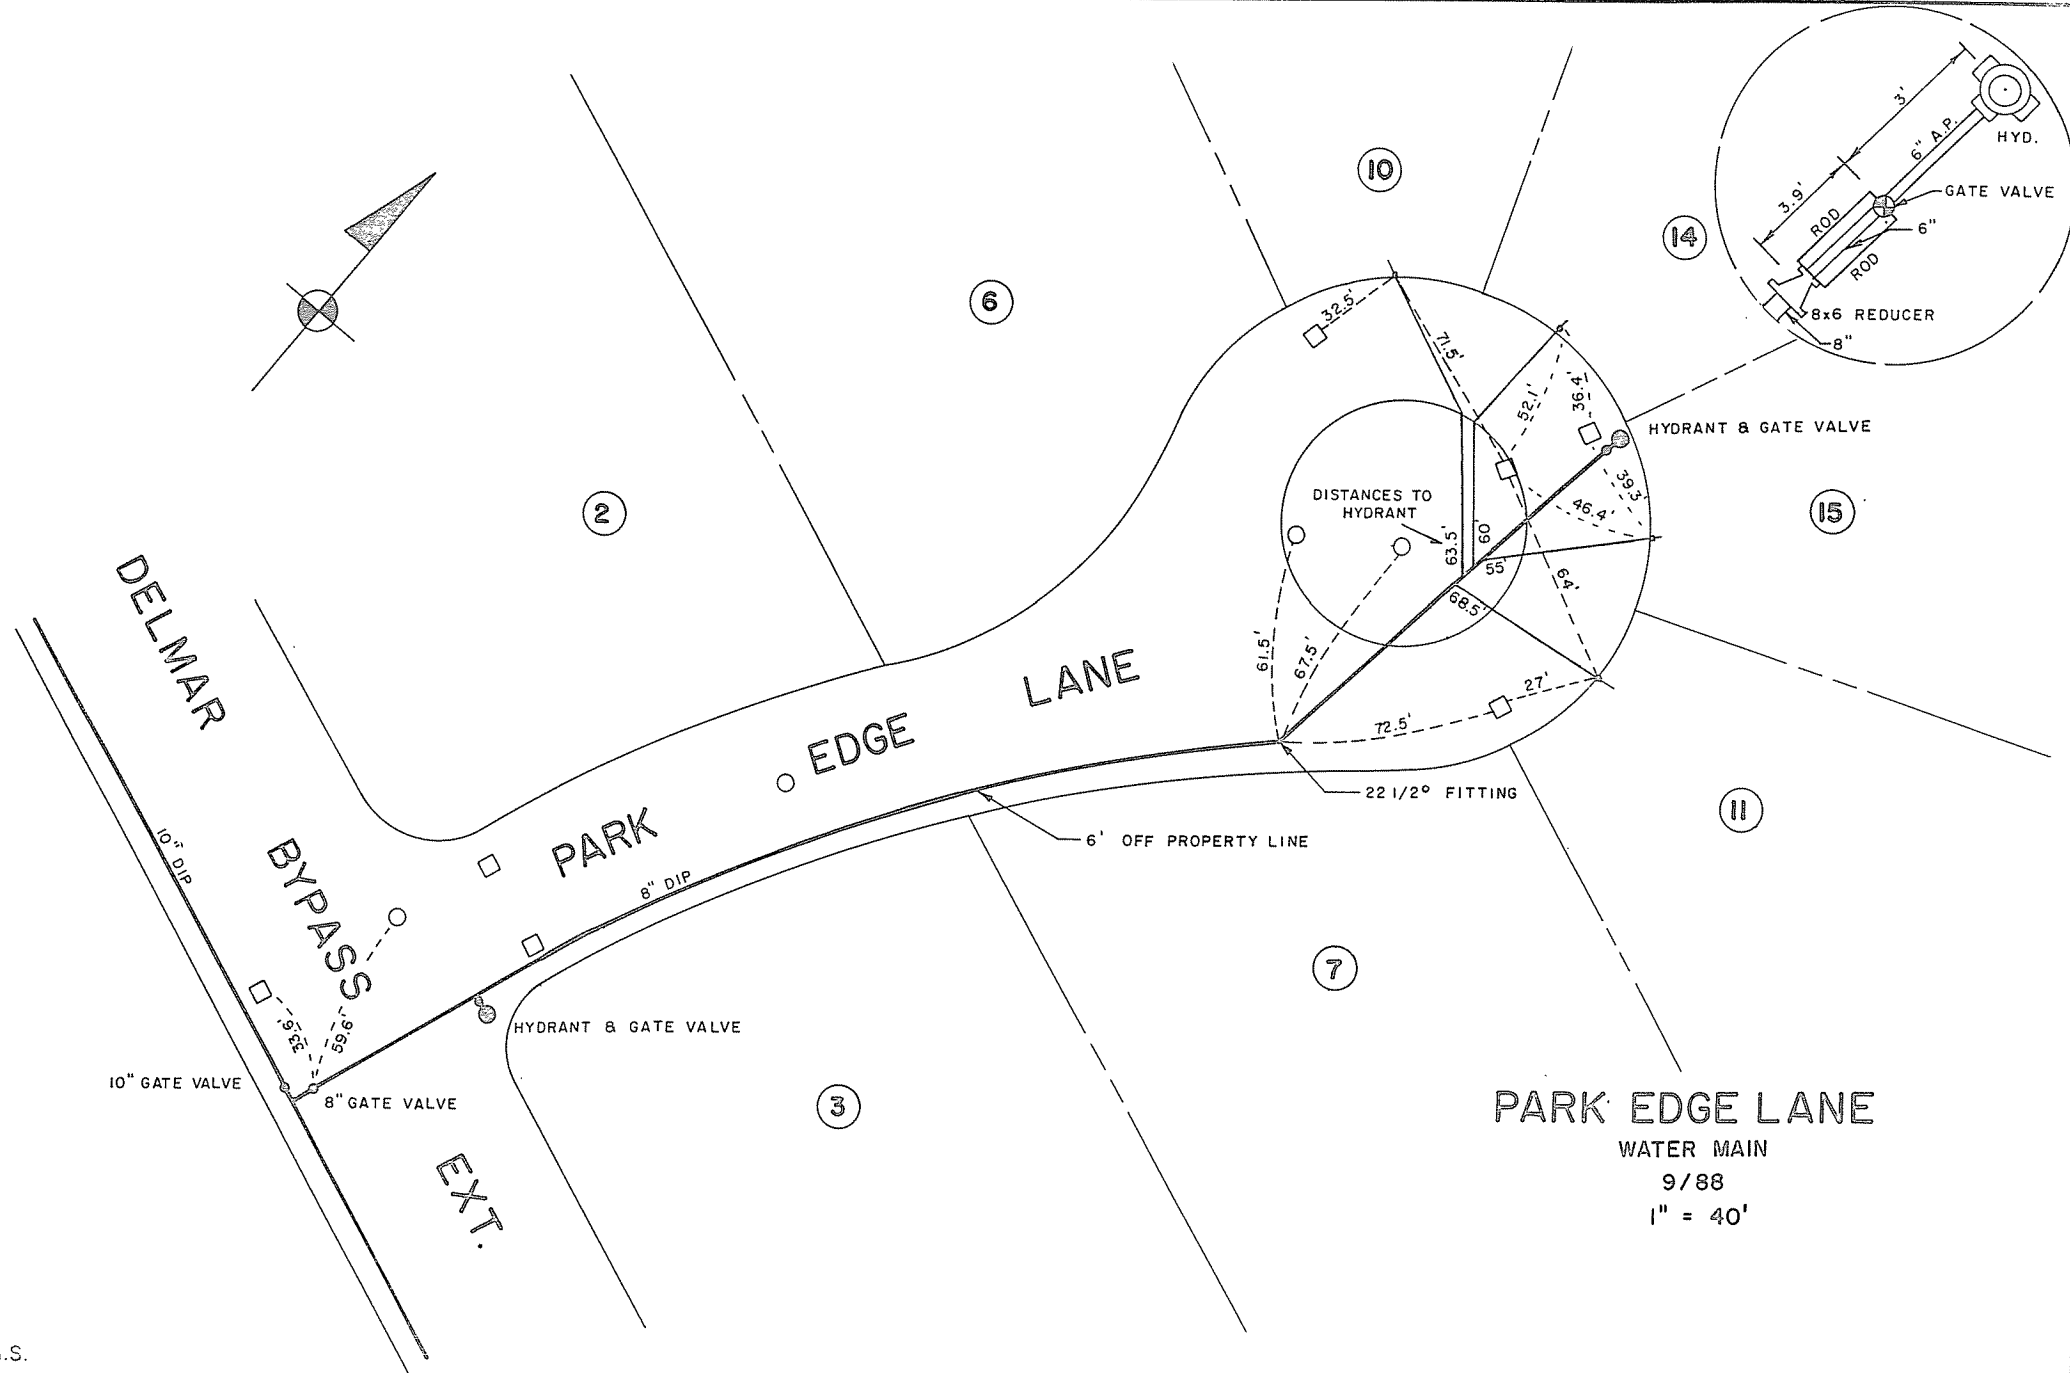


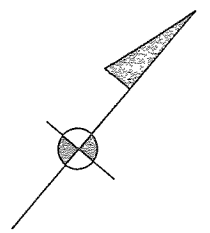

PARK EDGE LANE
WATER MAIN
9/88
1" = 40'